
T. 8 S., R. 5 W., W.M.

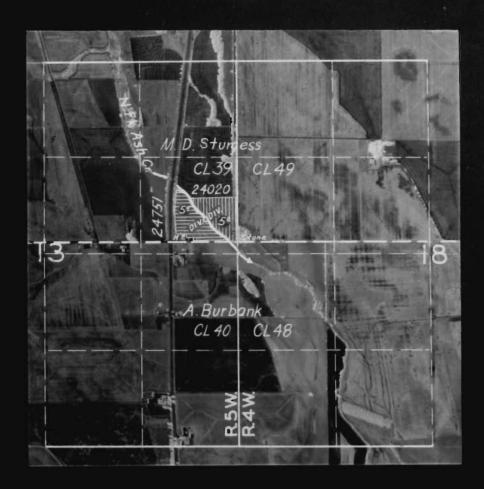

FINAL PROOF SURVEY

UNDER

Application No. 217.1. Permit No. 19514. IN NAME OF

Surveyed Aug. h 19 al, by C. Jon a.