


T.23S.R.32E.WM

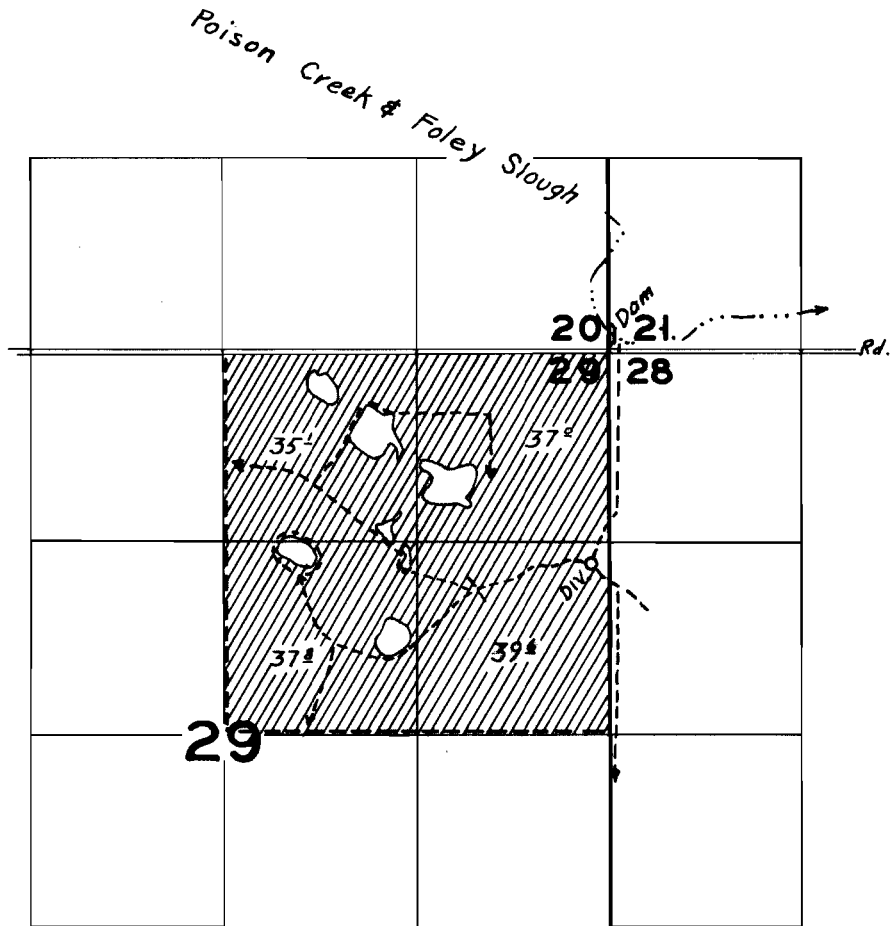

FINAL PROOF SURVEY

UNDER

Application No. 24812 Permit No. 19540

IN NAME OF

Treffle J. Duhaime

Surveyed June 28 1954, by H. L. Coffman