


T.6S.R.6W.WM

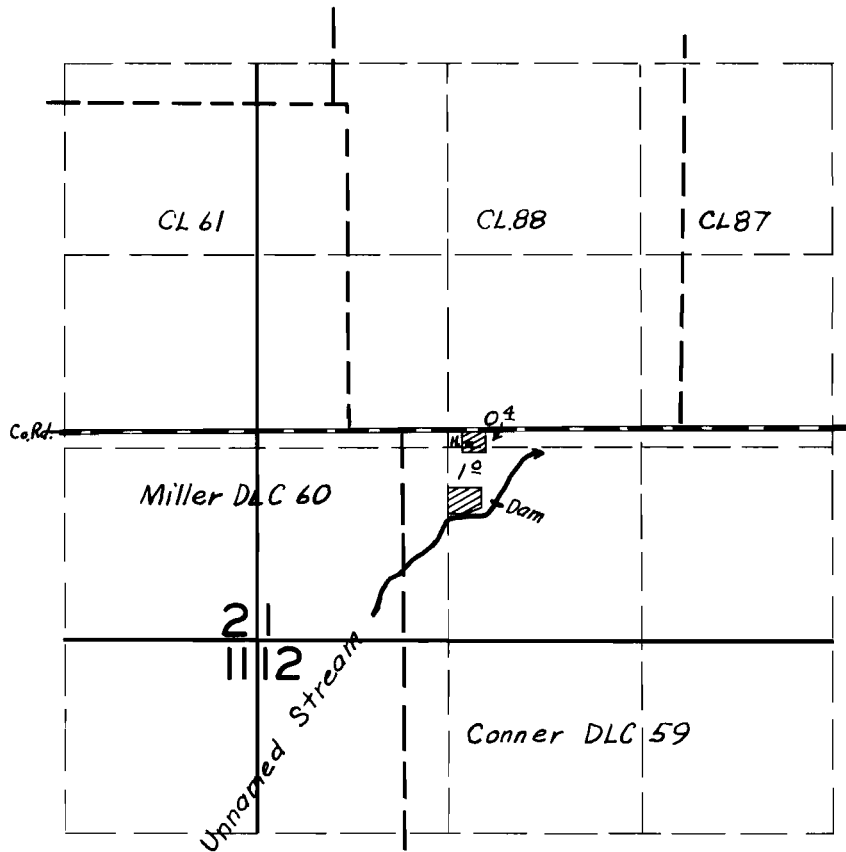

FINAL PROOF SURVEY

UNDER

Application No. 24821 Permit No. 19546

IN NAME OF

Edward A. & Alice R. Brandt

Surveyed July 13 19 54, by T. Jones

DFP-3D-04