


T.22S.R.33E WM

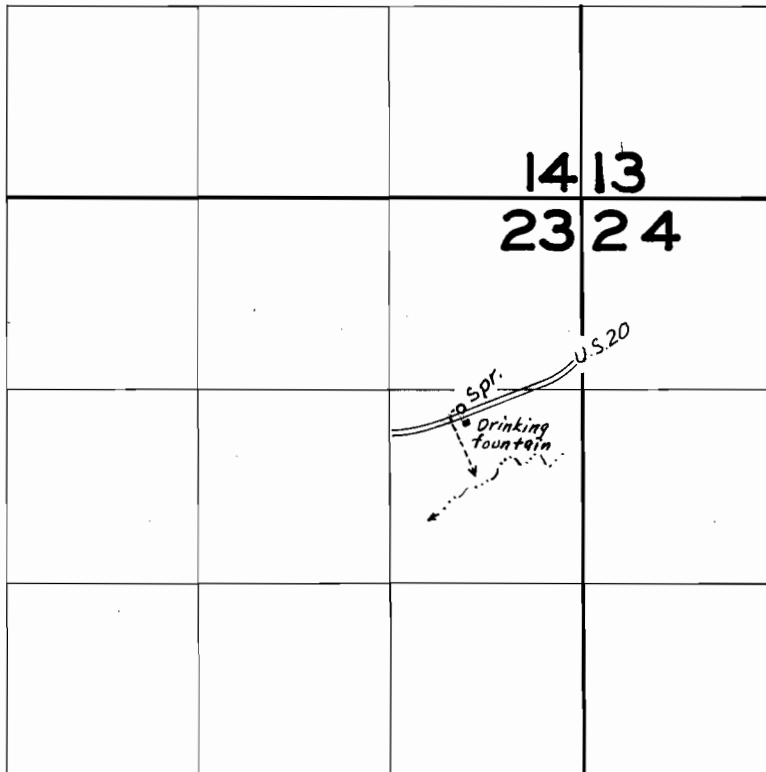

FINAL PROOF SURVEY UNDER

Application No. 21930 Permit No. 12502
IN NAME OF

Oregon State Highway Commission

Surveyed June 25, 1954, by T. Jones