


T.30S.R.4W WM

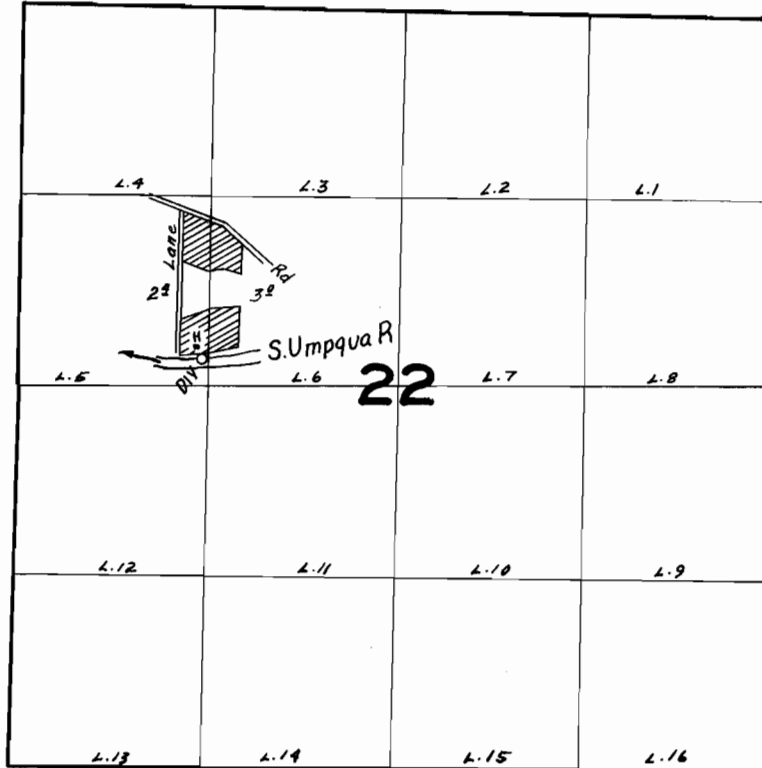

FINAL PROOF SURVEY UNDER

Application No. 25152 Permit No. 17705
IN NAME OF

Hiram J. Cash

Surveyed July 27 1954, by T. Jones