


T.10S.R.1W.WM

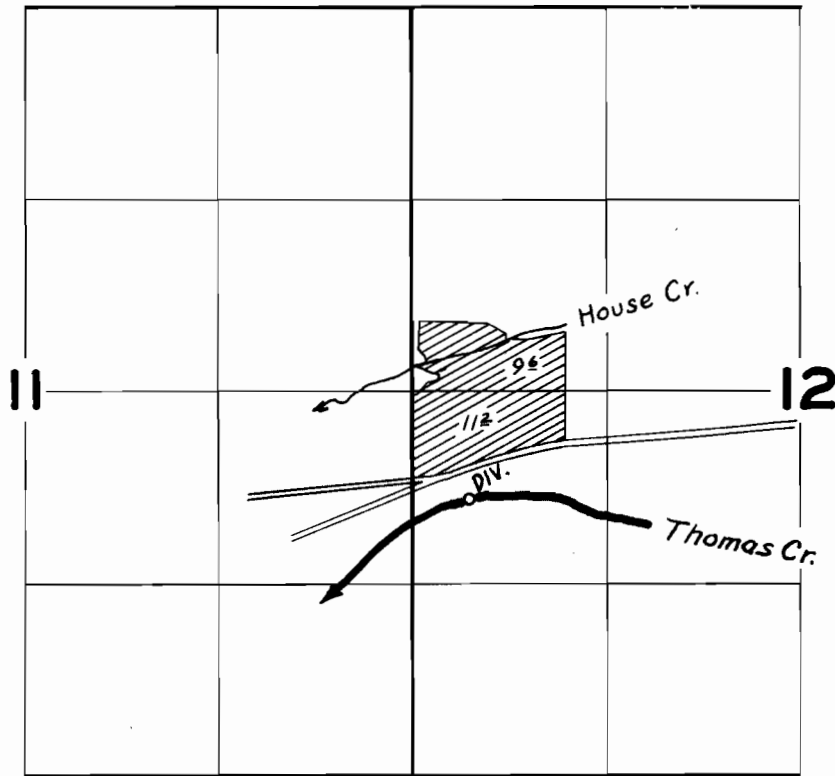

FINAL PROOF SURVEY UNDER

Application No. 25245 Permit No. 19831
IN NAME OF

K. A. and Helen Westenhouse

Surveyed July 12 1954, by H. L. Coffman