


T.13S.R.IW.WM

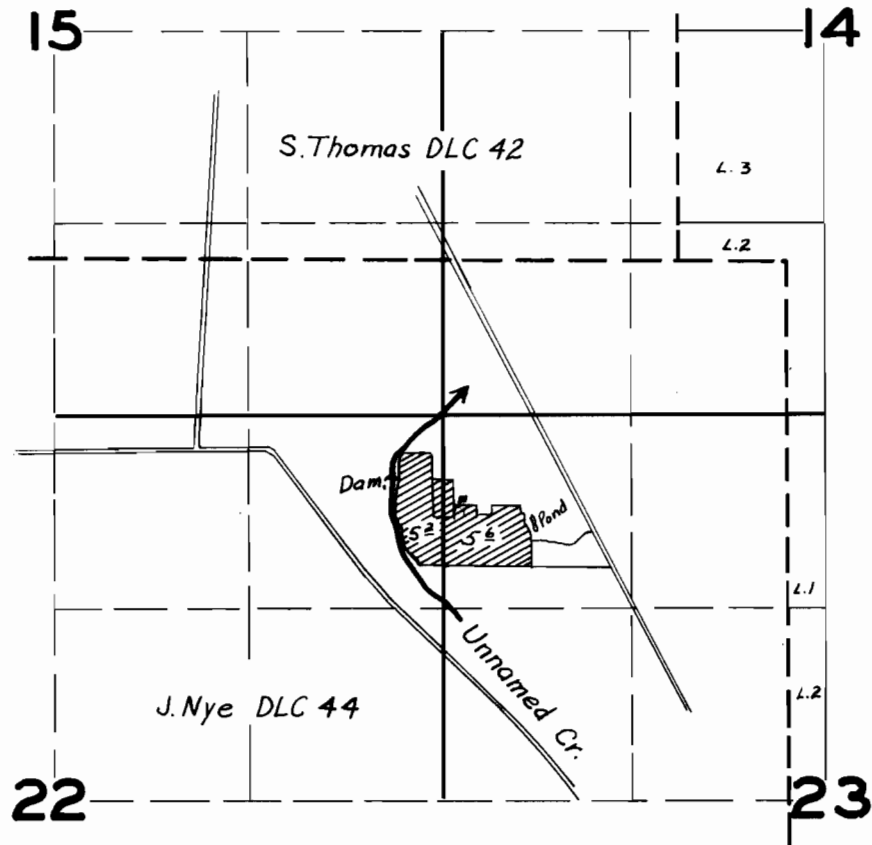

FINAL PROOF SURVEY

UNDER

Application No. 25230 Permit No. 19961
IN NAME OF

Henry Blankinship

Surveyed Aug. 16 1954, by H. L. Coffman