


# T. 21 S. R. 3 W. WM

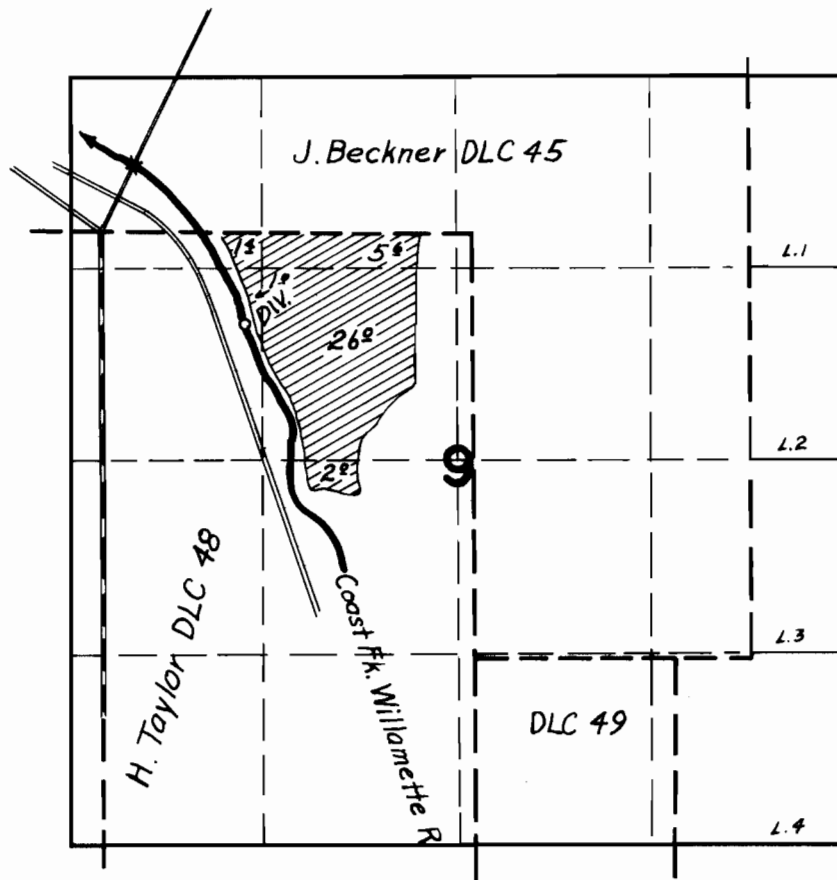

## FINAL PROOF SURVEY

UNDER

Application No. 25321 Permit No. 19976

IN NAME OF

William H. Pungus

Surveyed May 5, 1954, by T. Jones

10, -81-150