


T.19 S.R.1 W.WM

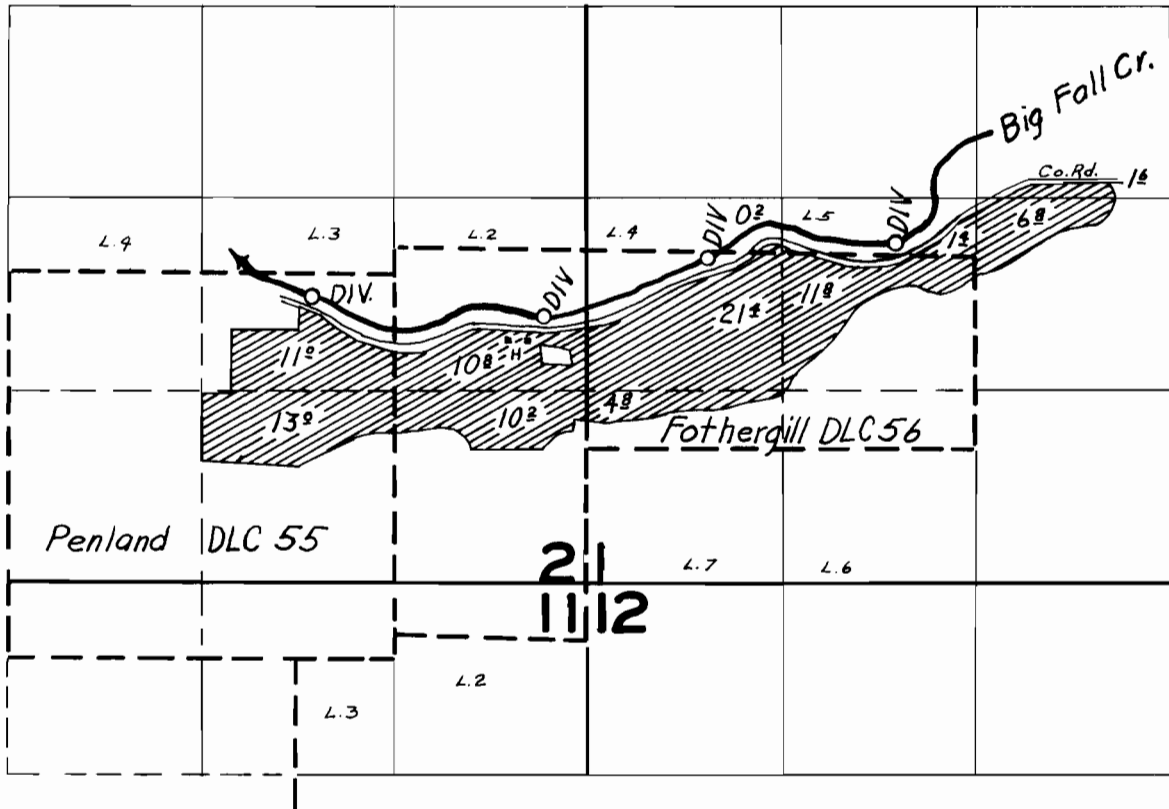

FINAL PROOF SURVEY

UNDER

Application No. 2111 Permit No. 2011

IN NAME OF

.....

Surveyed April 19, by