


T.15S.R.12W.WM

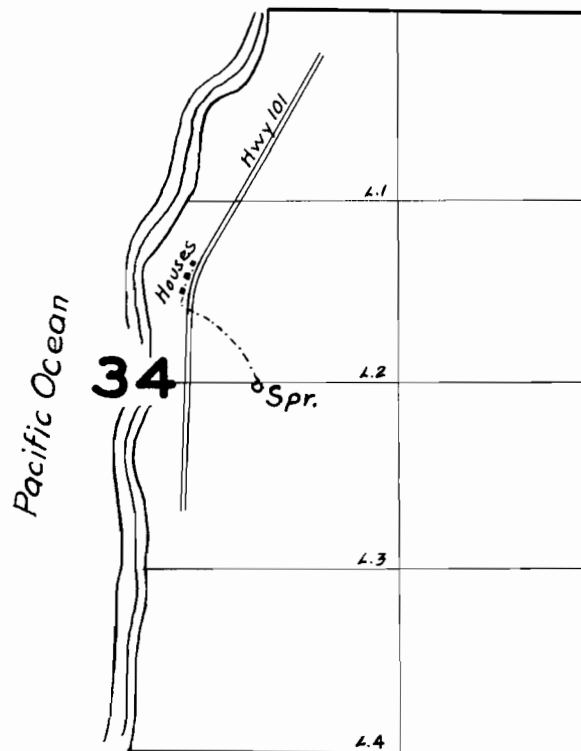

FINAL PROOF SURVEY
UNDER

Application No. _____ Permit No. _____
IN NAME OF

Surveyed _____ 19____, by _____