


T.25S. R. 6W.W. M.

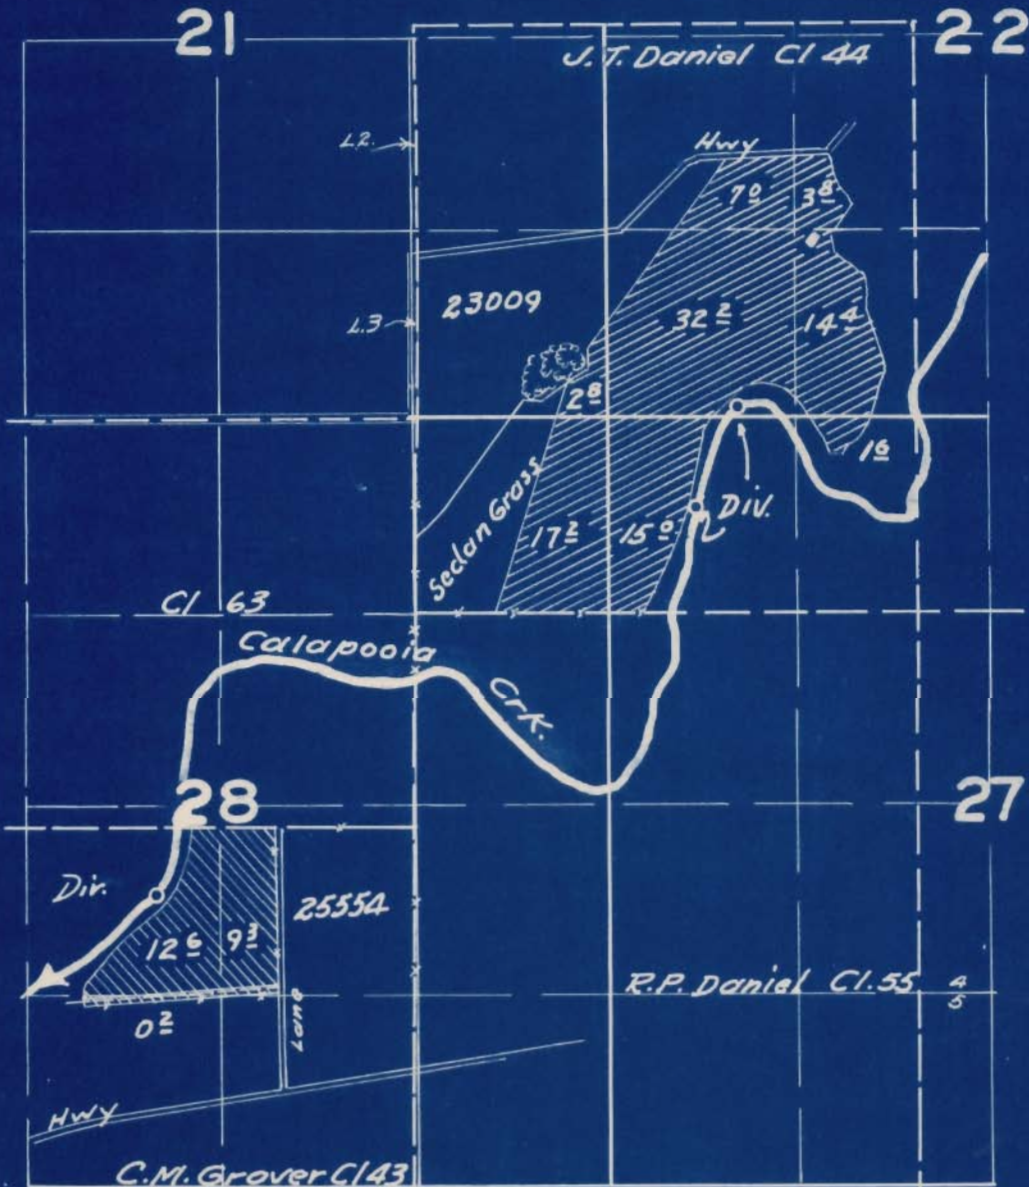

FINAL PROOF SURVEY

UNDER

Application No. 23009 Permit No. 18106
 Application No. 25554 Permit No. 20066

IN NAME OF
 Harold Grouch

C. L. Richardson

Surveyed July 25, 1954, by H. L. Coffman