


T.7S.R.1E.WM

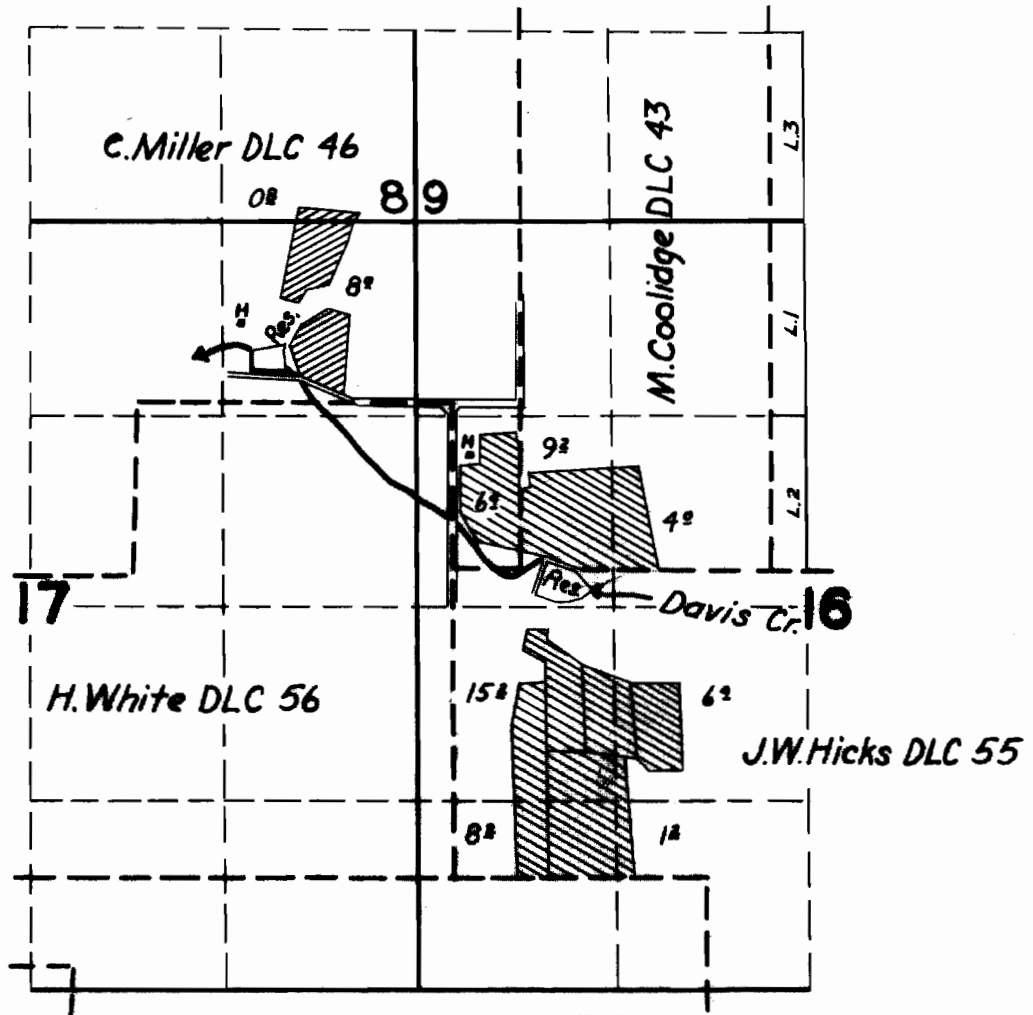

Appl. No. 26073

Appl. No. 24331

FINAL PROOF SURVEY

R-26072

26073

R-24330

R-1224

20567

R-1021

Application No. 24331 Permit No. 19342

IN NAME OF

Clay Porter

Victor J. Hadley and V.A. Tschant

Surveyed May 27 1954 by T. Jones