


T.28S.R.14W.W.M.

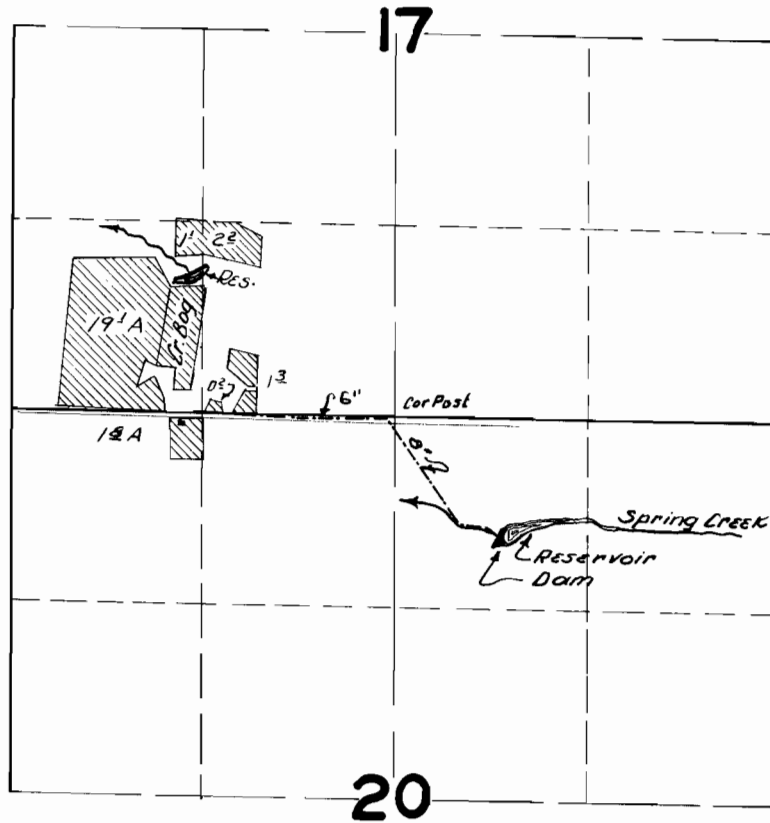

FINAL PROOF SURVEY
UNDER

Application No. 13309 . Permit No. 9550 .
IN NAME OF

HENRY F. WINTER

Surveyed SEPT. 21 1949, by H.L. COFFMAN.