


Sec. 26
138
3/E

Tp. _____
R. _____

Per # 9926
21243

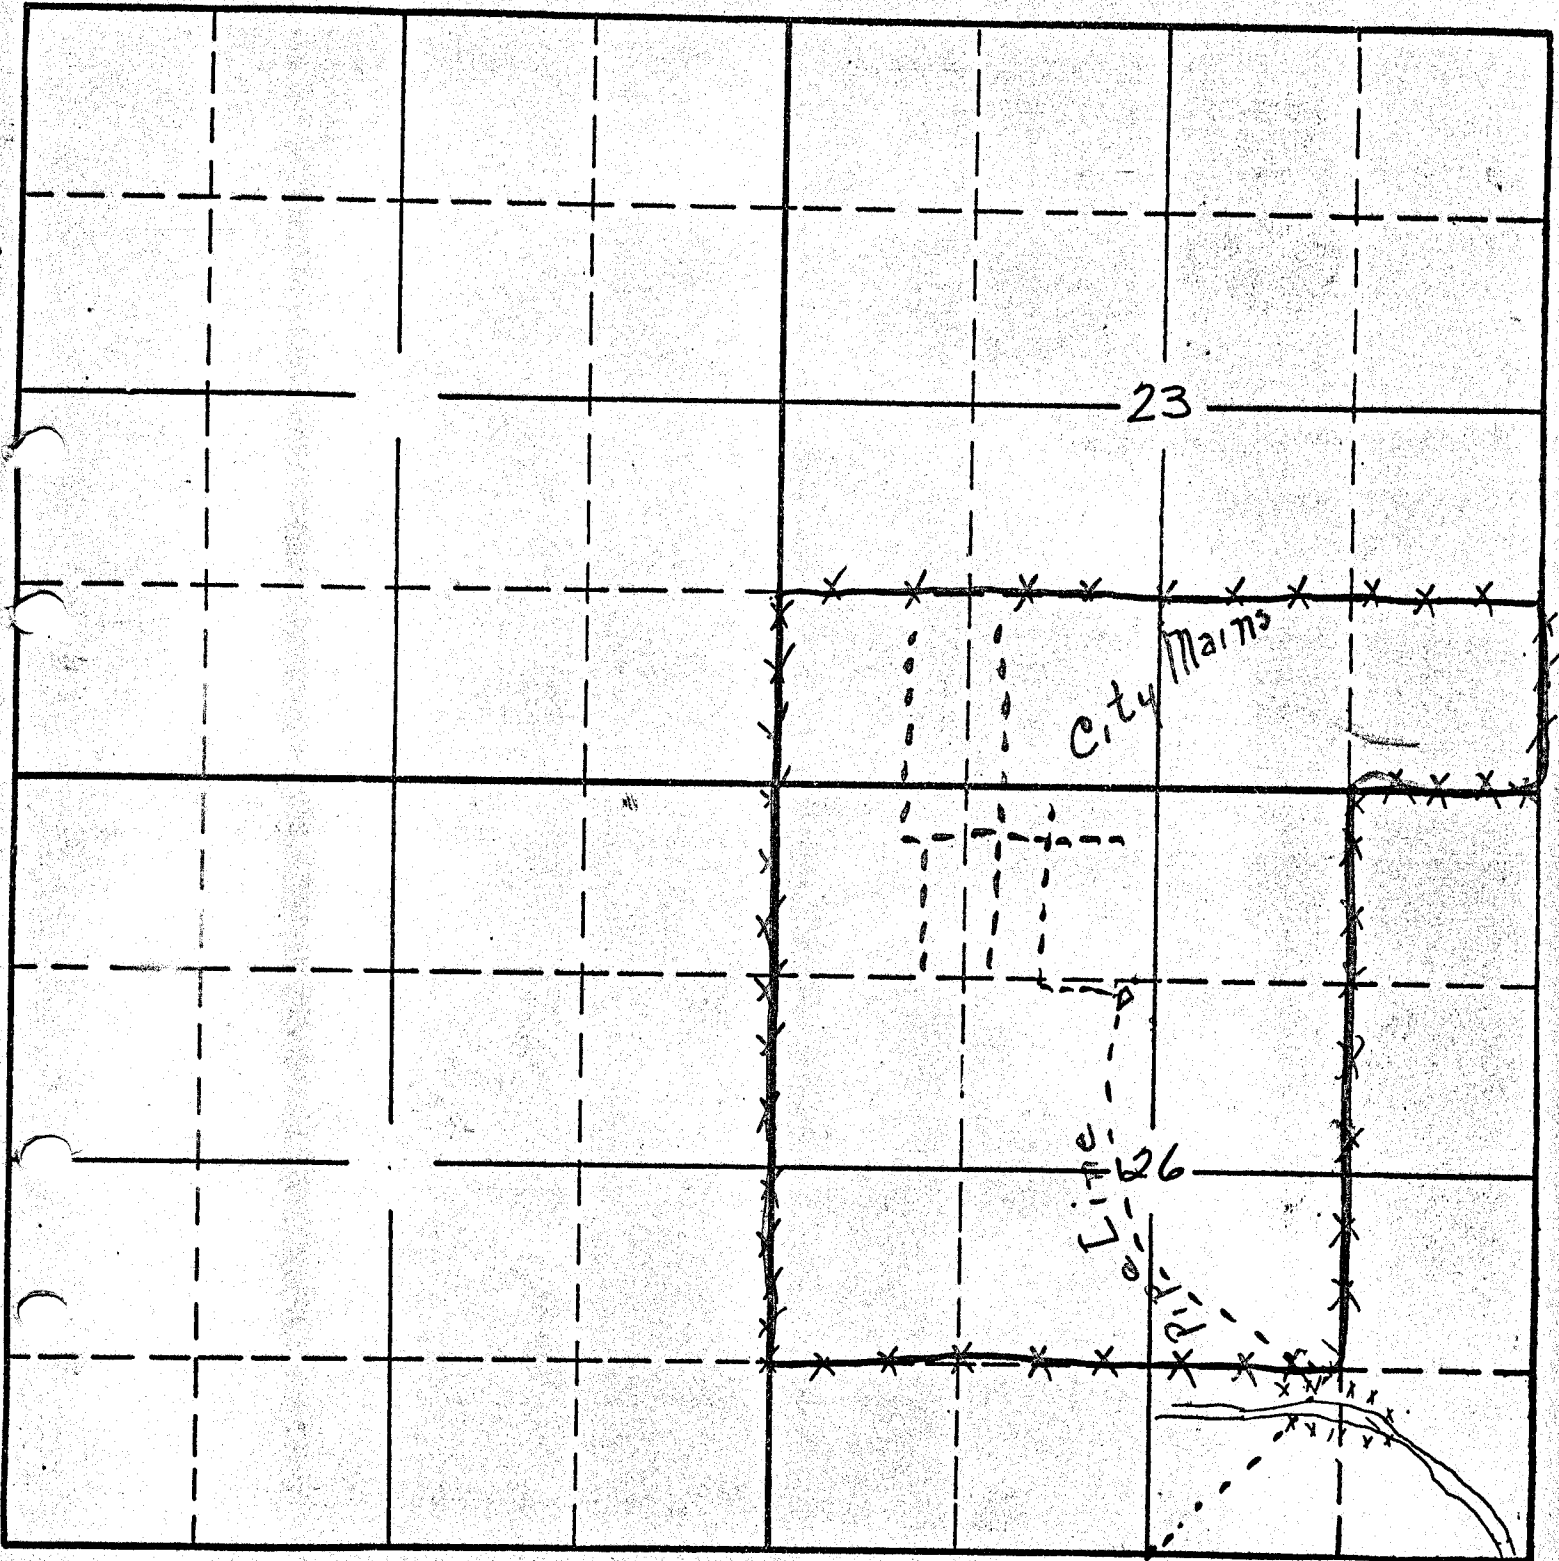

City of John

APP. No. 13739
PER. No. 9926

- xx Springs
- x Lona Gulech
- Pipe Line
- o Reservoir