


T. 2 S., R. 5 W., W.M.

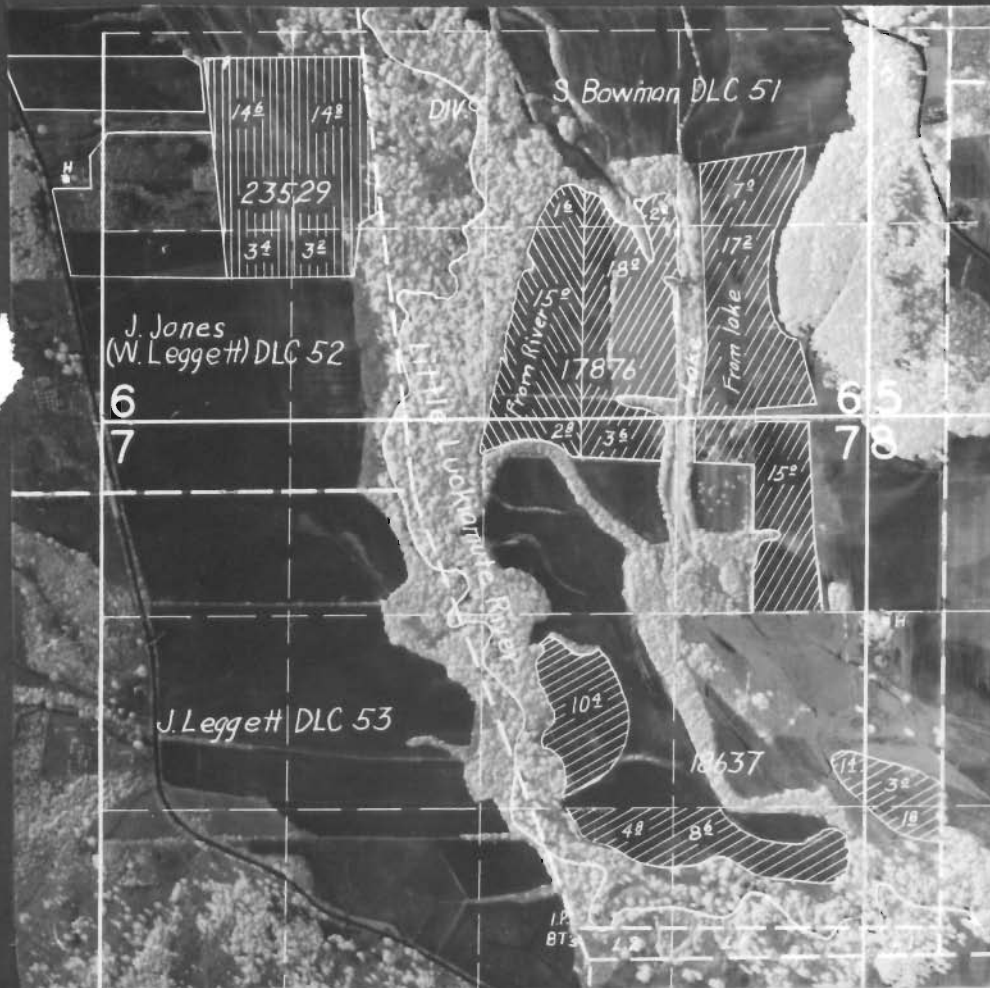

FINAL PROOF SURVEY

UNDER

Application No. 18837 Permit No. 11272
17876 13581
23529 18867

IN NAME OF

Lowell W. Kaup
Laird W. Kaup
Alton Upmeyer

Surveyed Aug. 6, 1951, by T. Jones