


T.2S.R.2W.W.M.

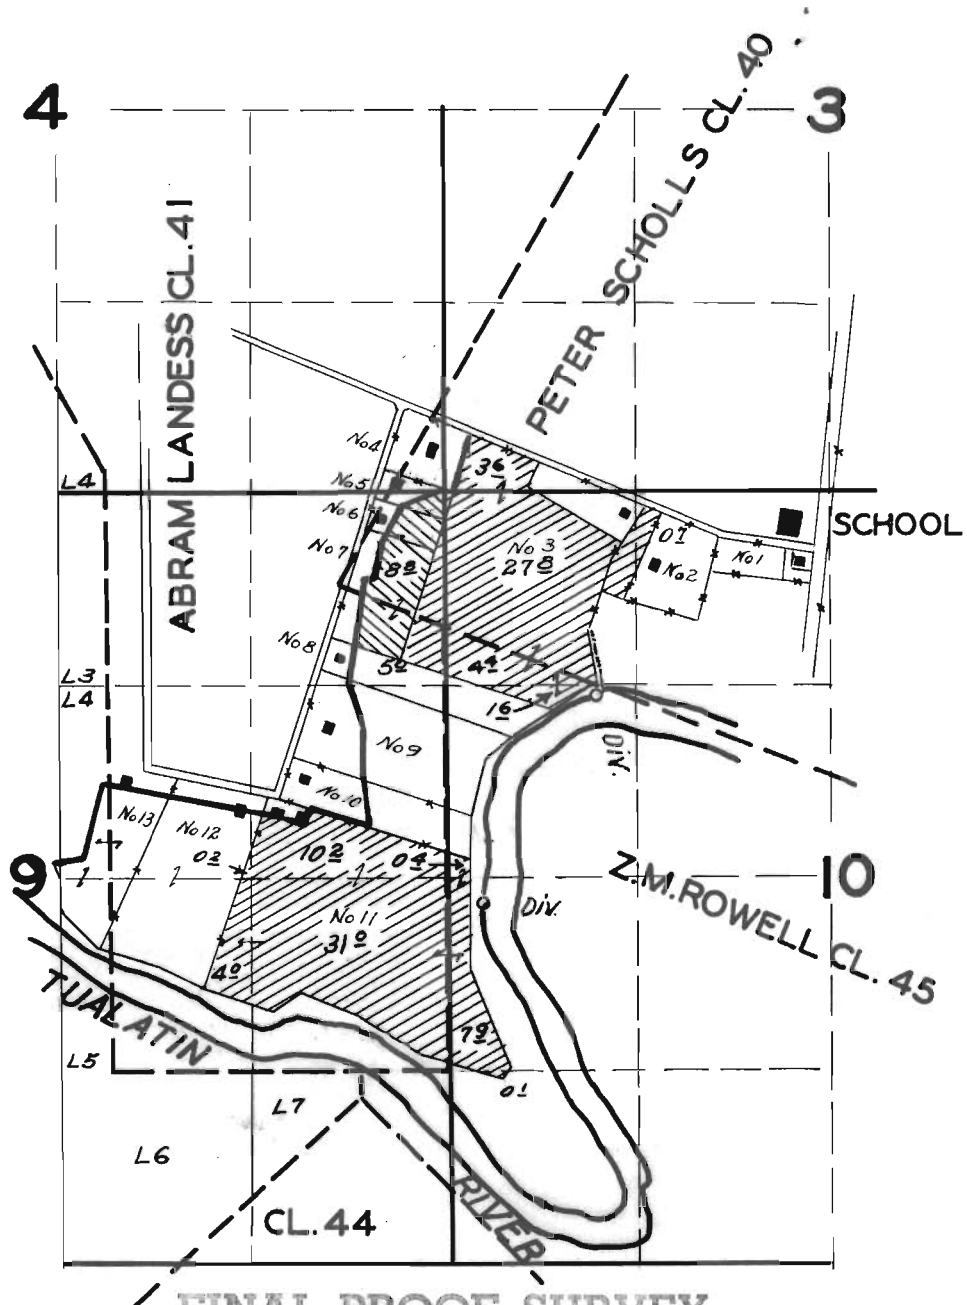

FINAL PROOF SURVEY

UNDER

Application No. 18624 Permit No. 11260

IN NAME OF

Ralph E. Alvord

Surveyed Aug. 2-3 1954, by H. L. Coffman.