


T.16S.R.5E.WM

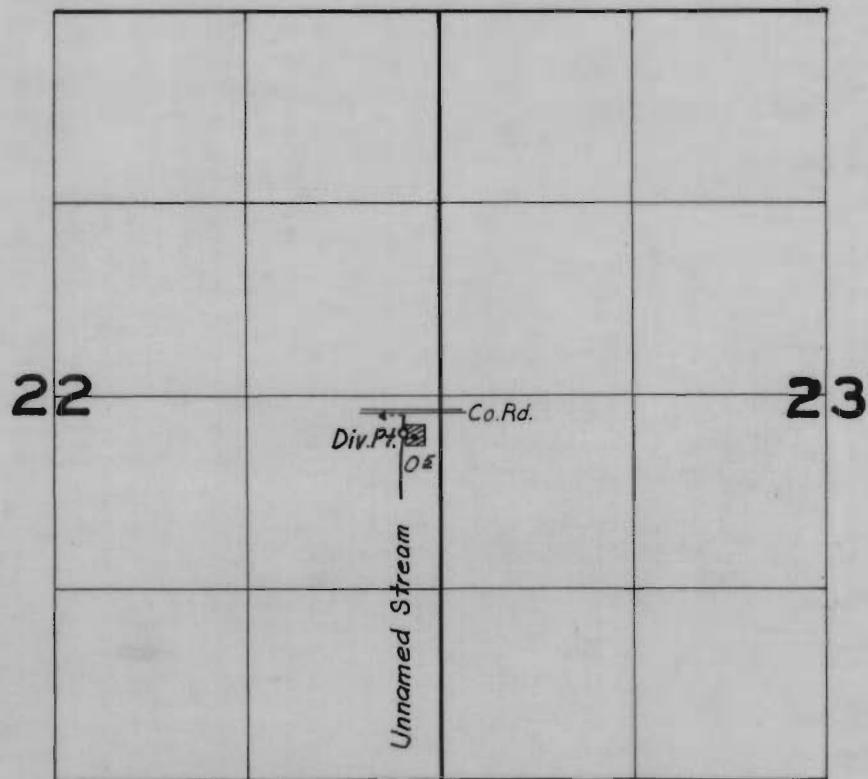

FINAL PROOF SURVEY
UNDER

Application No. 18856 Permit No. 111490
IN NAME OF

Joseph & Rose Harl

Surveyed July 15 1954, by T. Jones