


T.16 S ., R.1 W ., W.M.

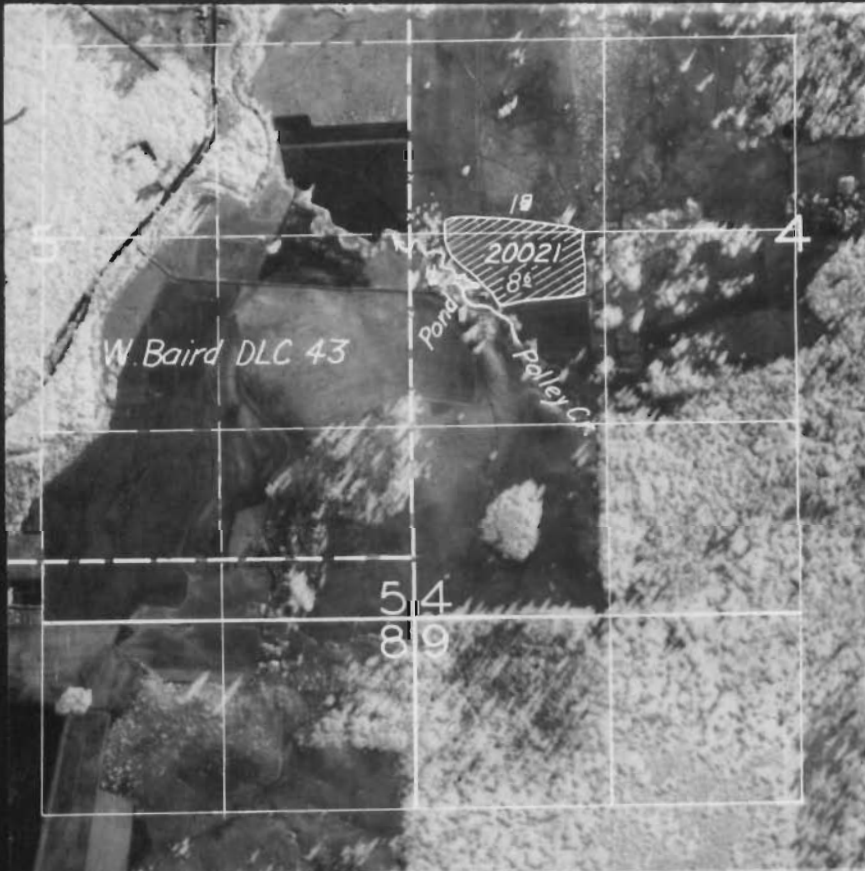

FINAL PROOF SURVEY
UNDER

Application No. 20021 Permit No. 15522
IN NAME OF

Martha J. Hileman

Surveyed April 2019 Sh., by T. Jones