


T. 28 S. R. 10 W. W. M.

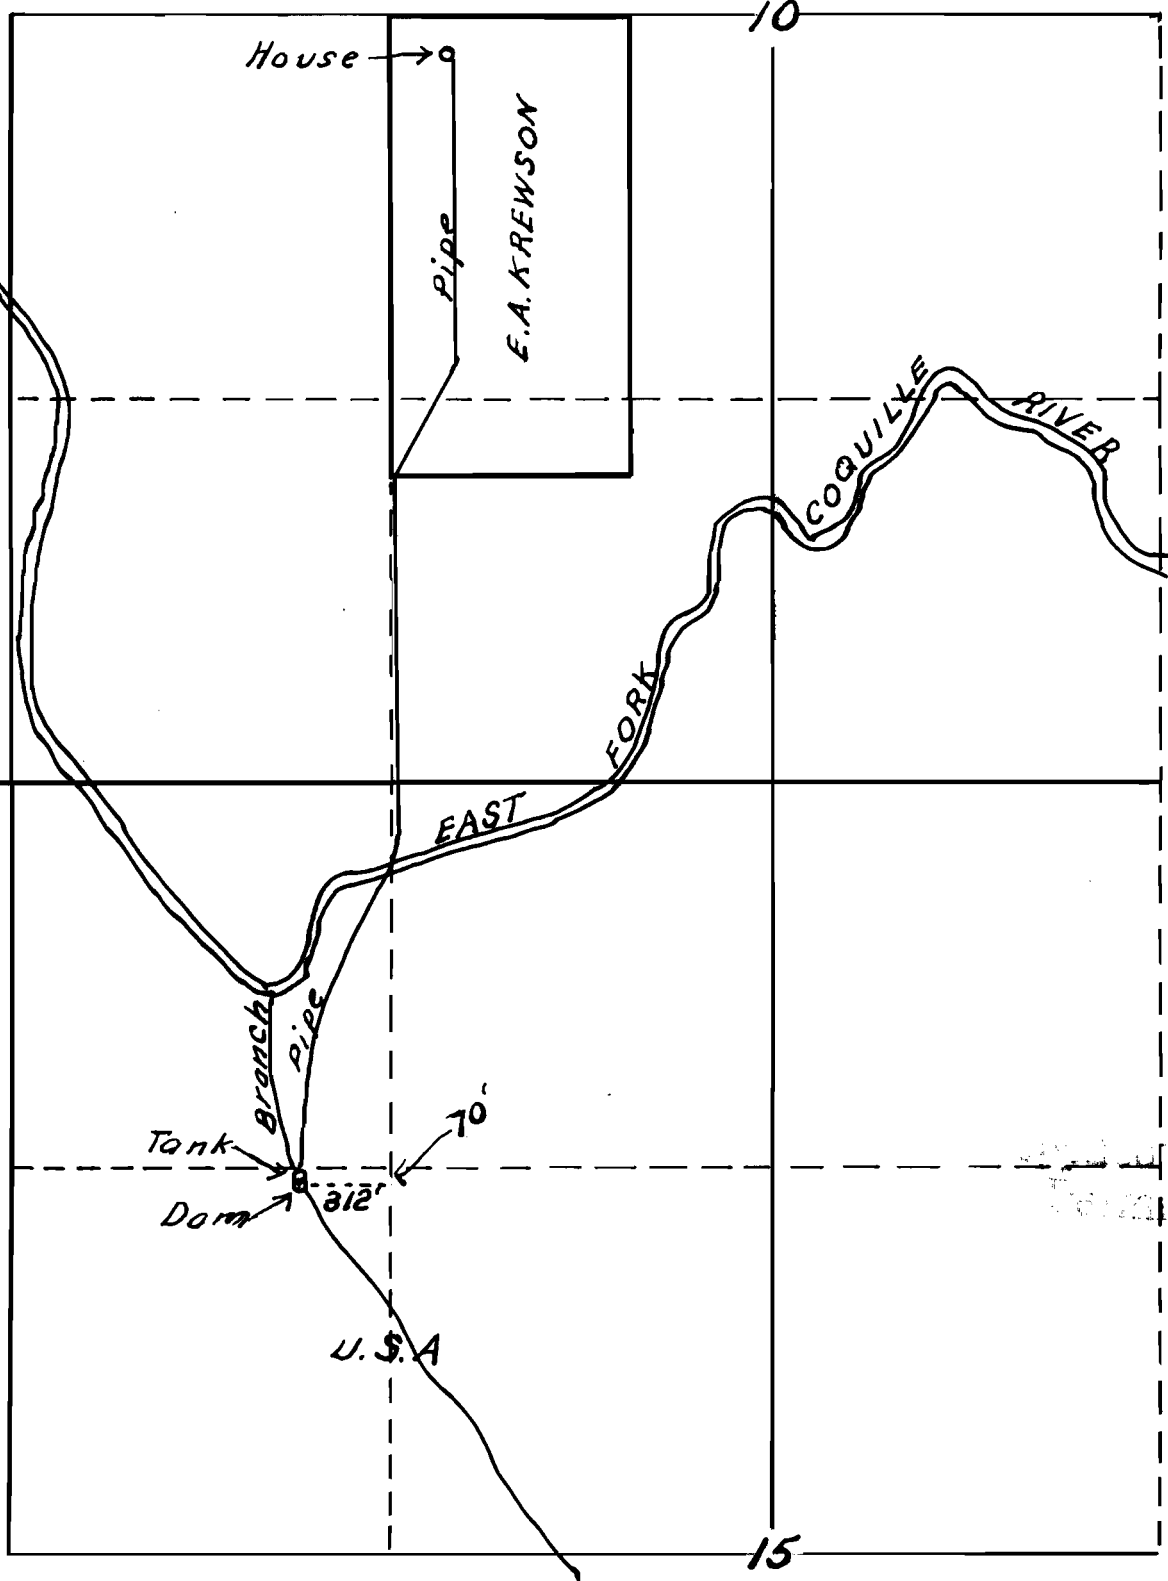

Scale:  
1 in. = 10 chs.

Map No. 20454  
Date 15971

Map accompanying application of  
A.E. KREWSON to appropriate water.

I, J.N. Gearhart, of Myrtle Point, Oregon, do hereby certify that this map was made from notes taken during an actual survey made under my immediate supervision on Aug. 1, 1944, and that it correctly represents the works described in the accompanying application, together with the location of streams in the immediate vicinity.

J. N. Gearhart No. 183