


T.19 S., R. 5 W., W.M.

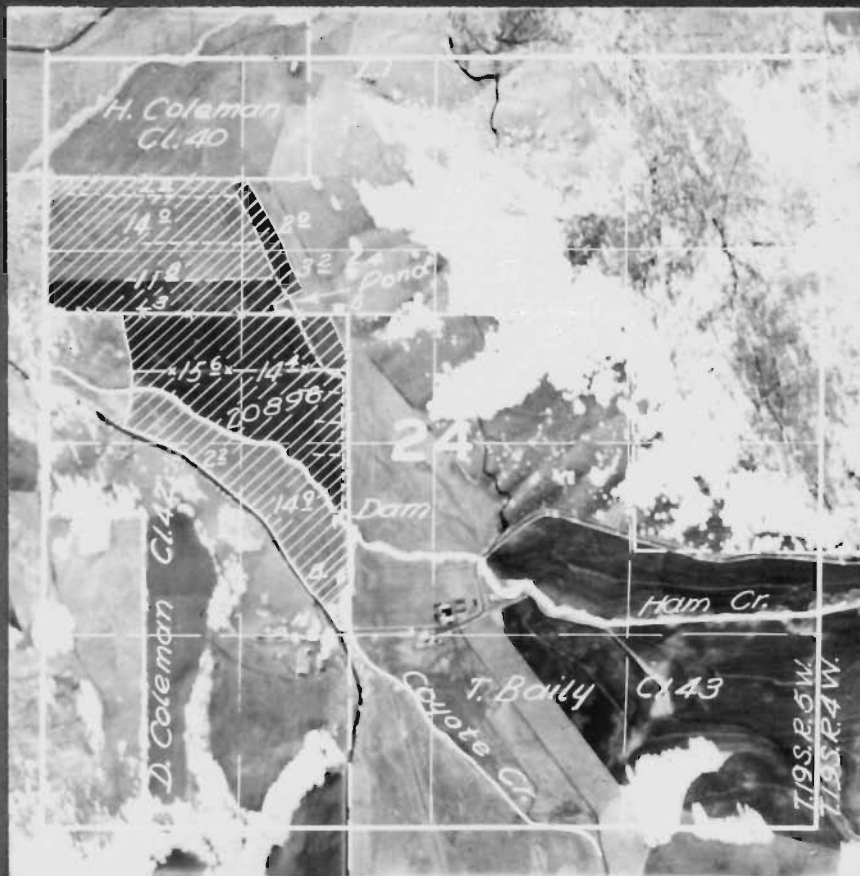

FINAL PROOF SURVEY
UNDER

Application No. 20896 Permit No. 16366
IN NAME OF

Robert Wills

Surveyed April 30 1954, by H. L. Coffman

DBQ-7H-139