


T.9S.R.6W.WM

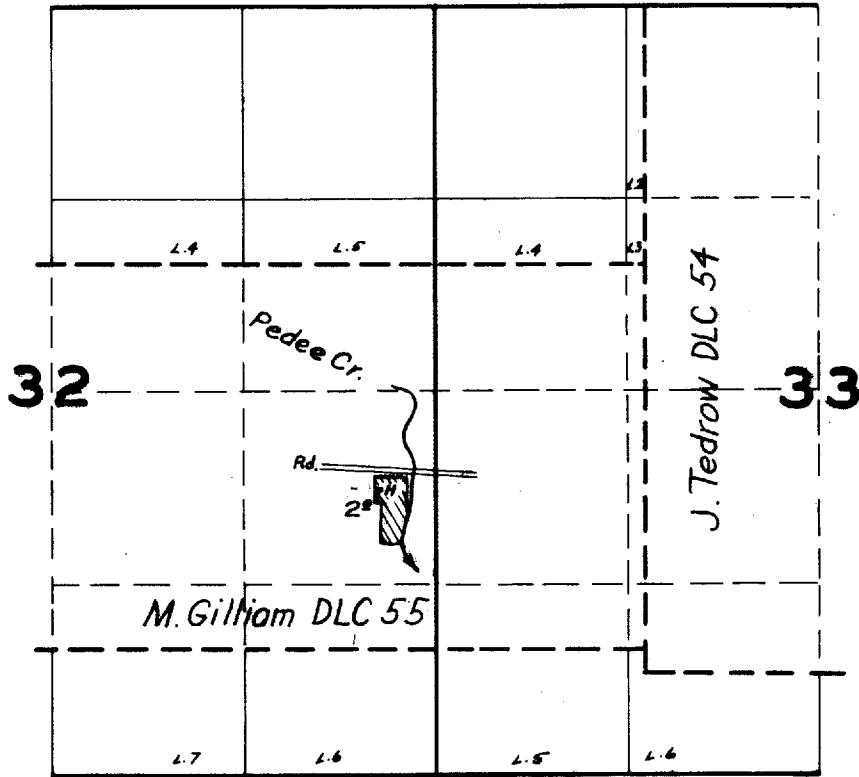

FINAL PROOF SURVEY UNDER

Application No. 21120 Permit No. 16803
IN NAME OF

Rufus E. Dodge

Surveyed July 13, 1954, by T. Jones