


T.21S.R.4 W.W.M.

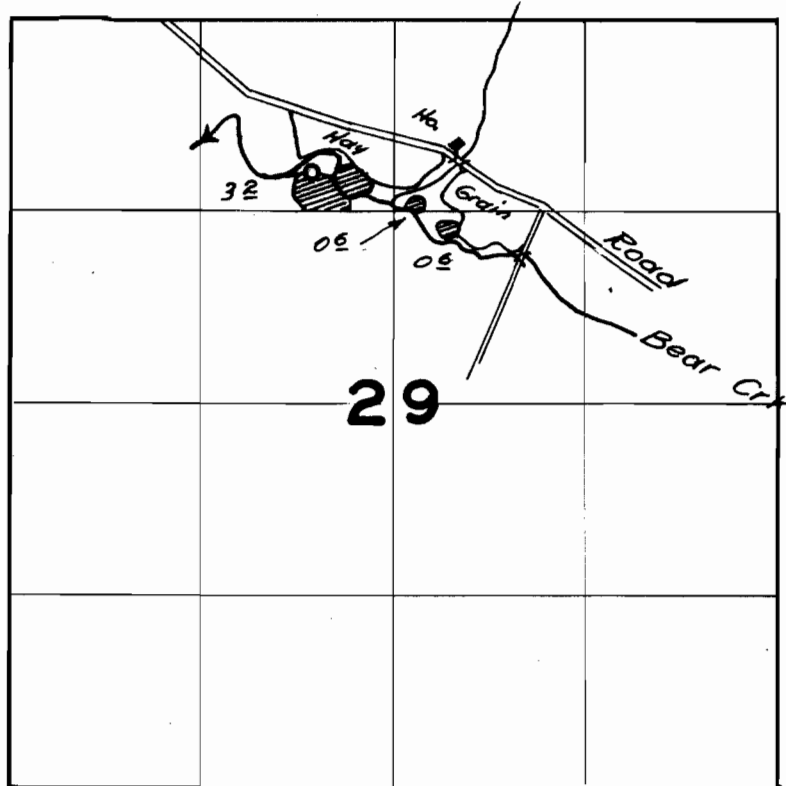

FINAL PROOF SURVEY

UNDER

Application No. 22043 Permit No. 17312

IN NAME OF

..... Andrew C. Redifer

Surveyed July 27, 1954, by H. L. Coffman

Dd-Hw-31-11
Pantograph