


T. 19 S., R. 1 W., W.M.

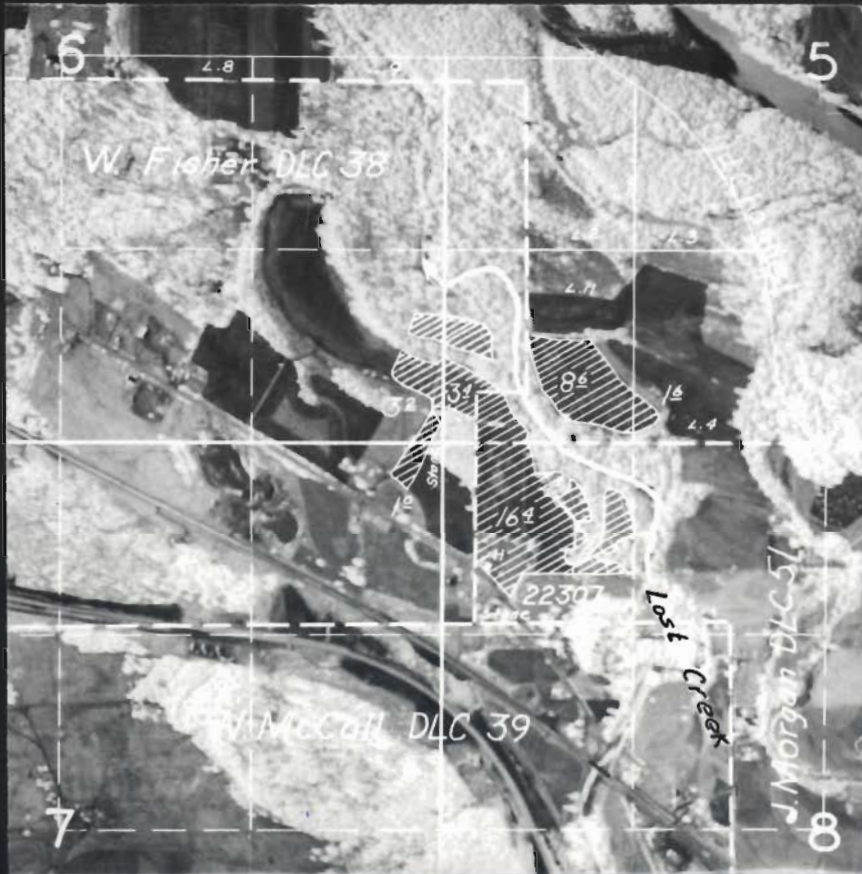

FINAL PROOF SURVEY
UNDER

Application No. 22307 Permit No. 17590
IN NAME OF

Merle D. Chase

Surveyed April 29 1954, by T. Jones