


# T. 29 & 30 S. R. 5 W. WM

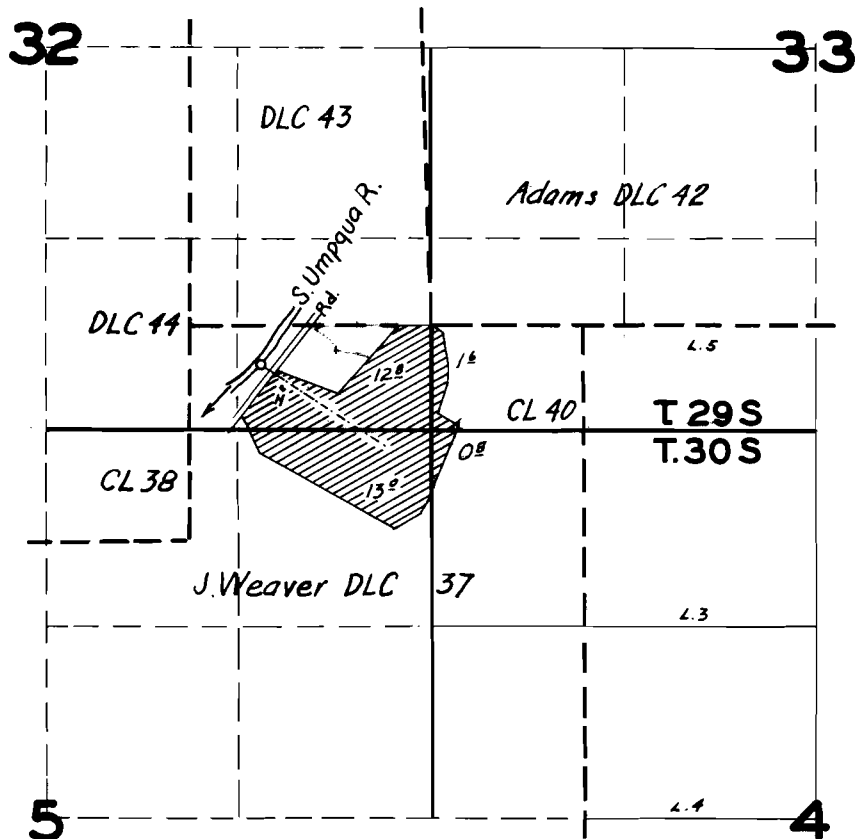

## FINAL PROOF SURVEY

UNDER

Application No. 22420 Permit No. 17372

IN NAME OF

Charles J. Weaver

Surveyed July 20, 1954, by T. Jones