


T.2S.R.12E.WM

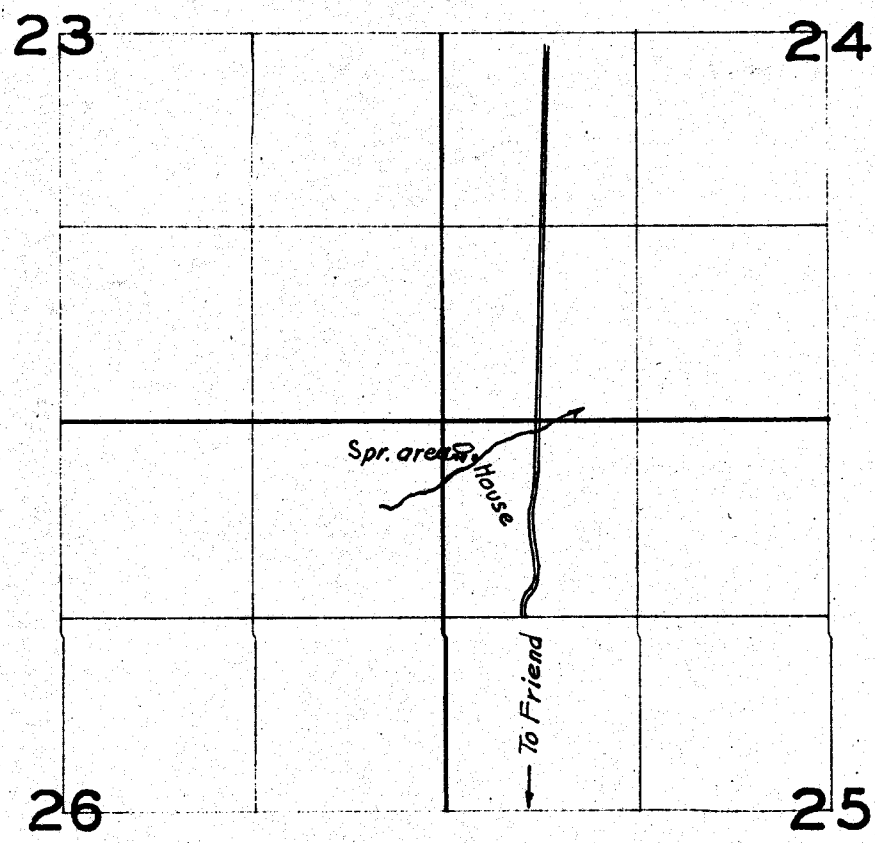

FINAL PROOF SURVEY UNDER

Application No. 22176 Permit No. 17733

IN NAME OF

W. D. Allen

Surveyed April 1924, by F. Jones