


T. ., R. ., W.M.

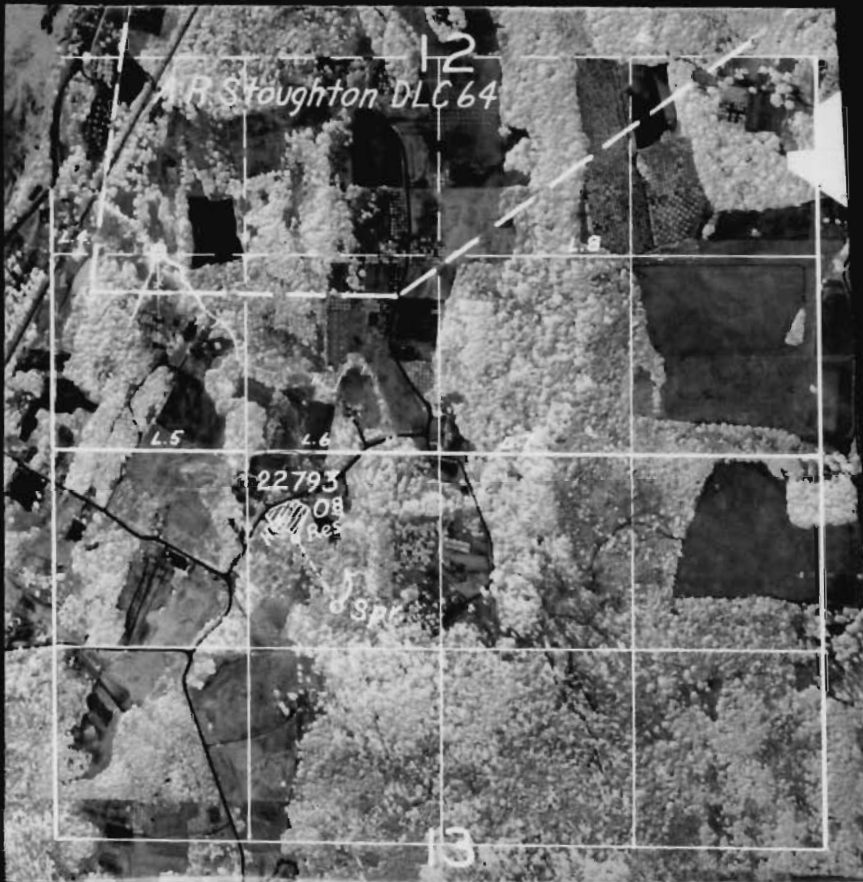

**FINAL PROOF SURVEY**  
UNDER

Application No. 22793..... Permit No. 17978.....  
IN NAME OF

.....George E. Weeks.....

Surveyed April 16 1954, by T. Jones.....

DEFN 4D 78