


T. 8 S., R. 3 W., W.M.

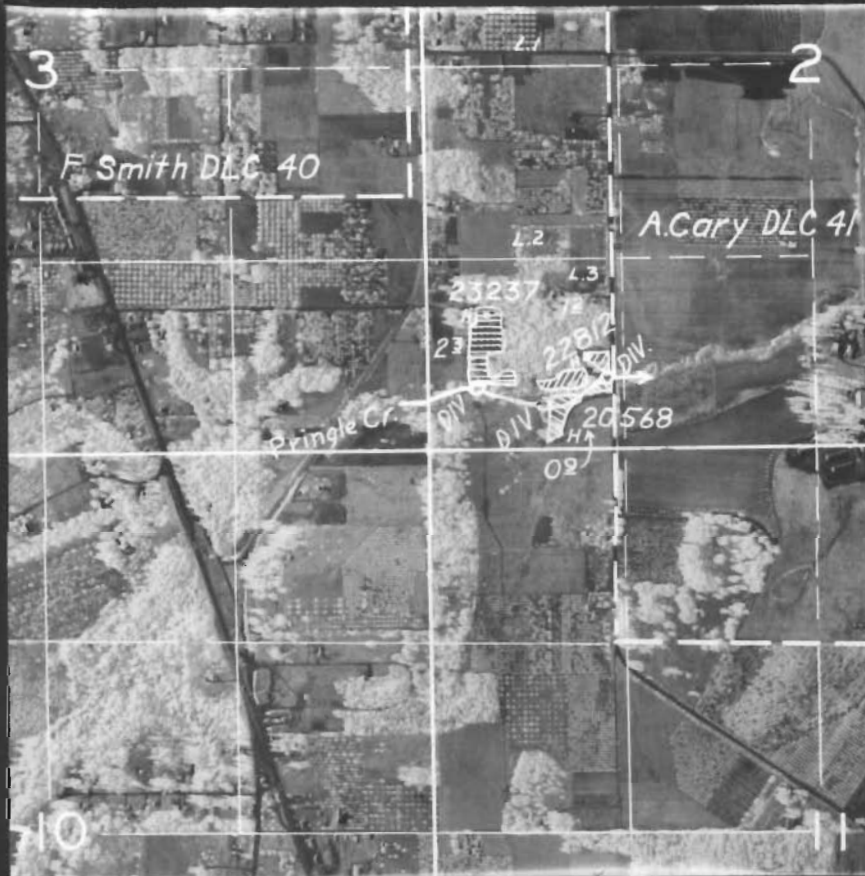

FINAL PROOF SURVEY

| Name | Appl. No. | Permit No. |
|------------------------|-----------|------------|
| Dr. William L. Lidbeck | 20568 | 16055 |
| F. P. Colgan | 23237 | 18303 |
| W. W. McKinney | 22812 | 18038 |

Surveyed April 13 1954, by T. Jones....

DFN 3D 60