


T. 7S.R. 5 & 6 W.WM

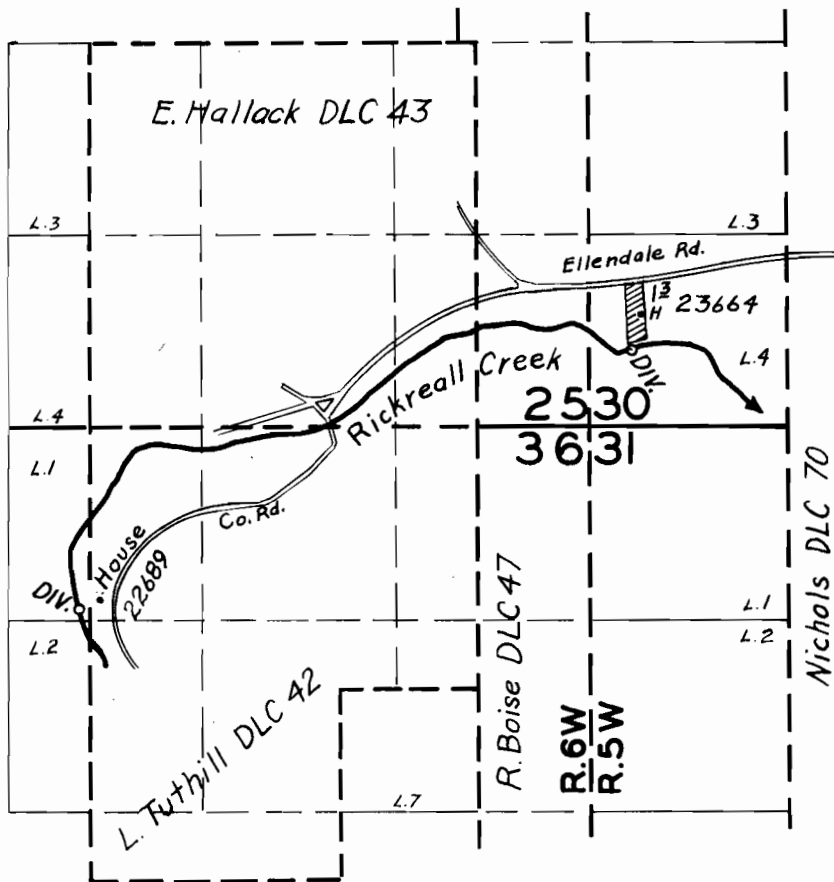

FINAL PROOF SURVEY

UNDER

Application No. 23664 Permit No. 10722

IN NAME OF

E. Hallack

of T. 7S. R. 5 & 6 W. WM

Surveyed 10/17/19, by [Signature]