


T. 6S. R. 6W. WM

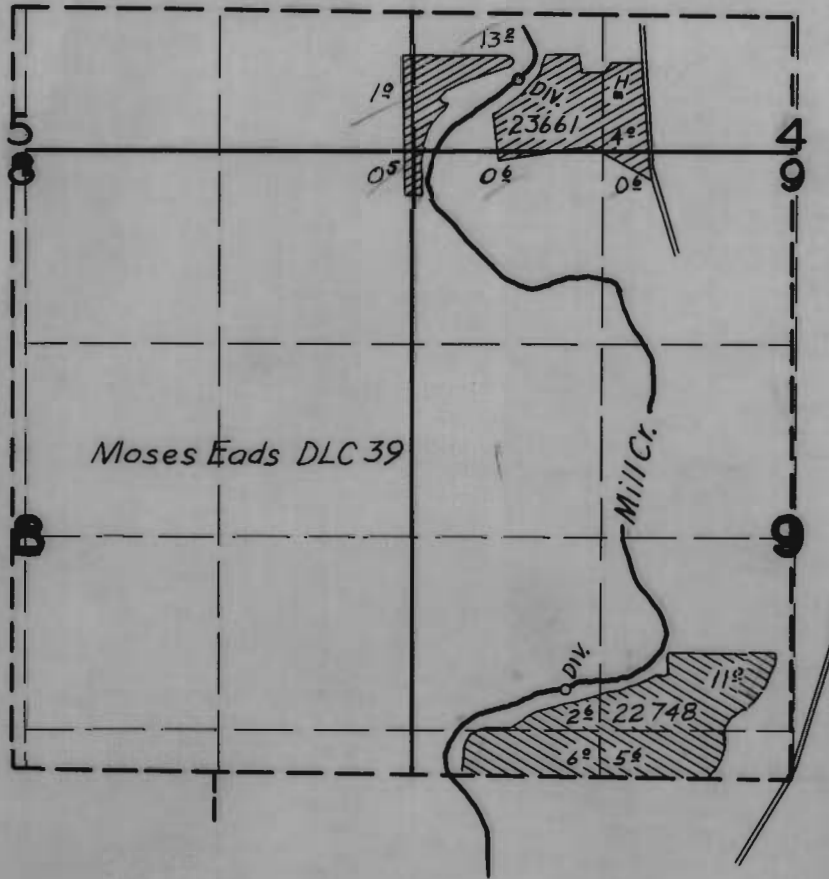

FINAL PROOF SURVEY

UNDER

Application No. 22748 17935  
23661 Permit No. 18805

IN NAME OF

Hugh Veach  
W. H. Hibbert

Surveyed July 12 19 54, by T. Jones