


T. 8 S., R. 5 W., W.M.

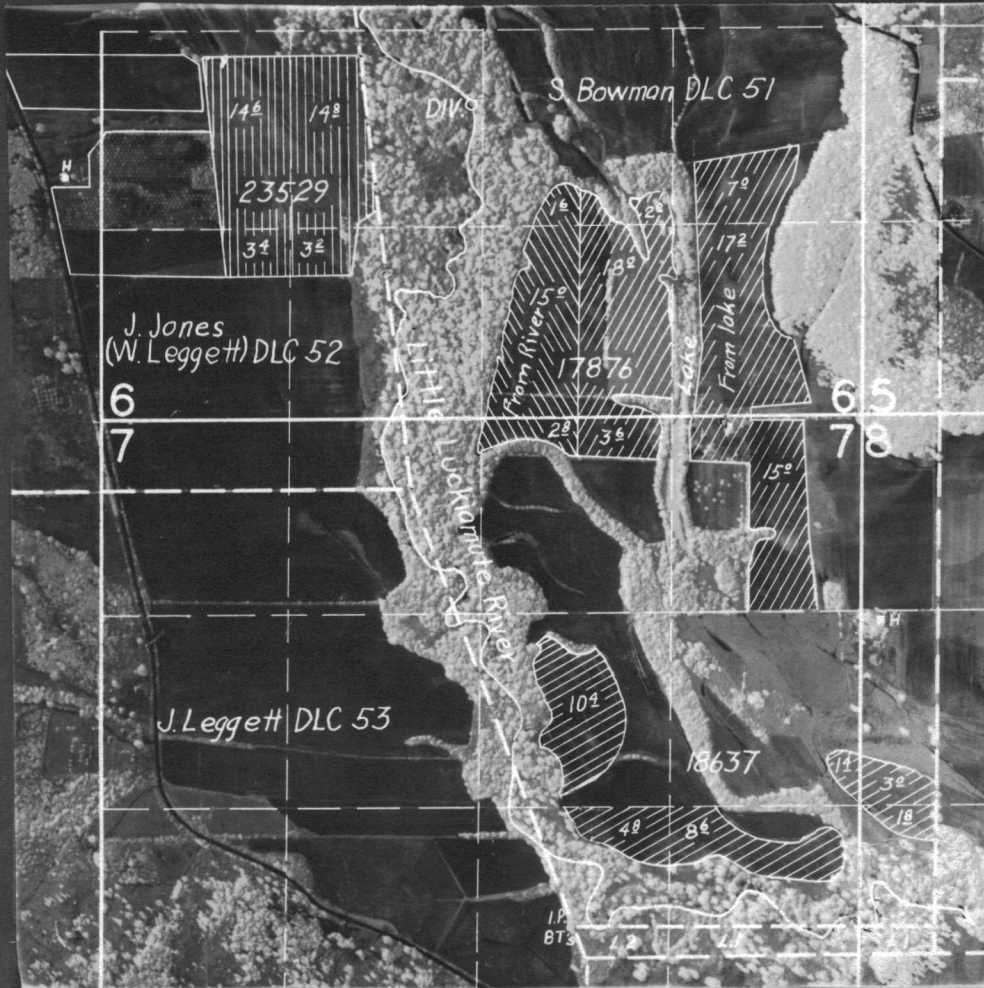

### FINAL PROOF SURVEY

UNDER

Application No. ~~18837~~ 23529 Permit No. ~~14272~~ 18867  
~~17876~~

IN NAME OF

Lowell W. Kaup  
Laird W. Kaup  
Alton Upmeyer

Surveyed Aug. 6, 1954, by T. Jones