


T. ., R. ., W.M.

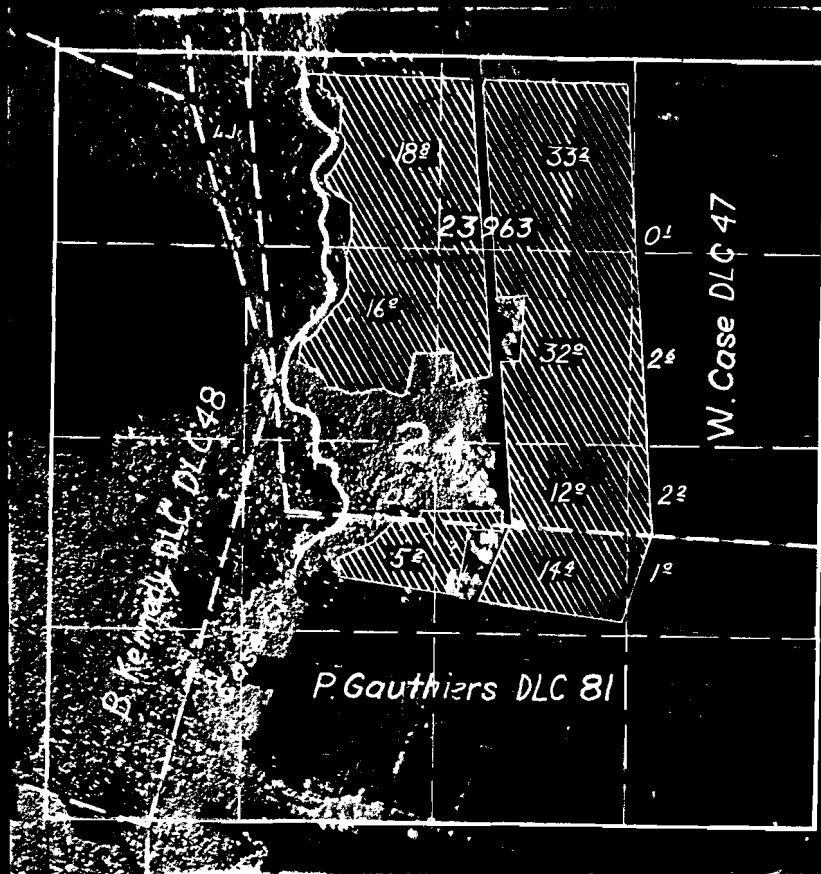

FINAL PROOF SURVEY

UNDER

Application No. _____ Permit No. _____
IN NAME OF

Surveyed _____ 19____, by _____