


T.12S.R.1W.WM

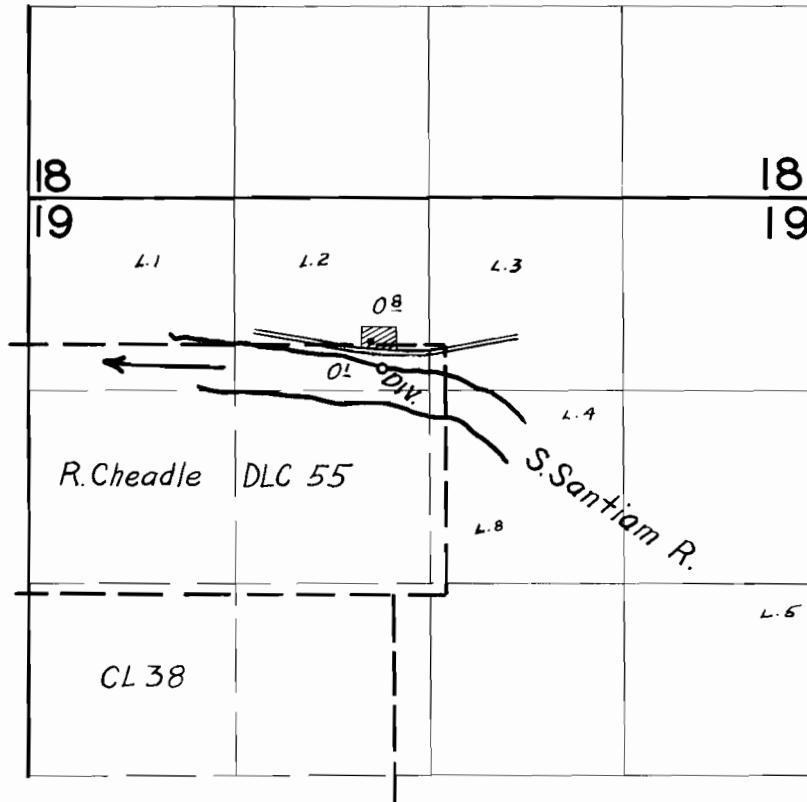

FINAL PROOF SURVEY

UNDER


IN NAME OF

... Kenneth and Oral Childs ...

Surveyed Aug. 5, 1954, by ... L. L. Hoffman