


T.6&7S.R.4W. WM

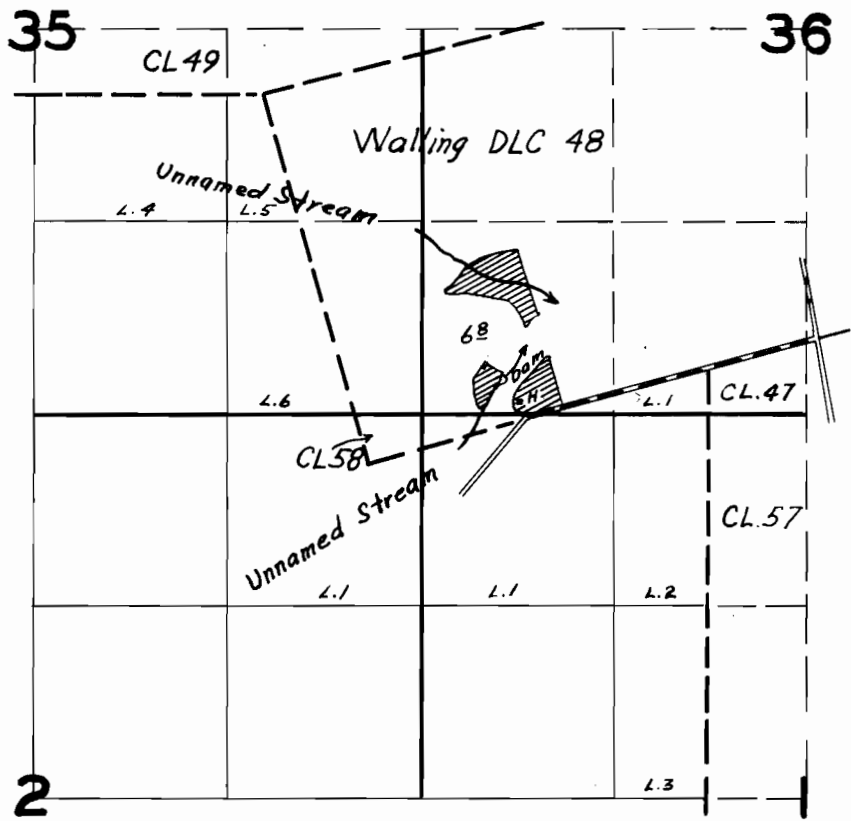

FINAL PROOF SURVEY
UNDER

Application No. 25099 Permit No. 19754
IN NAME OF

Philip M. and Eunice C. Brandt

Surveyed Aug. 19, 1954, by T. Jones