


T.IOS.R.I W. WM

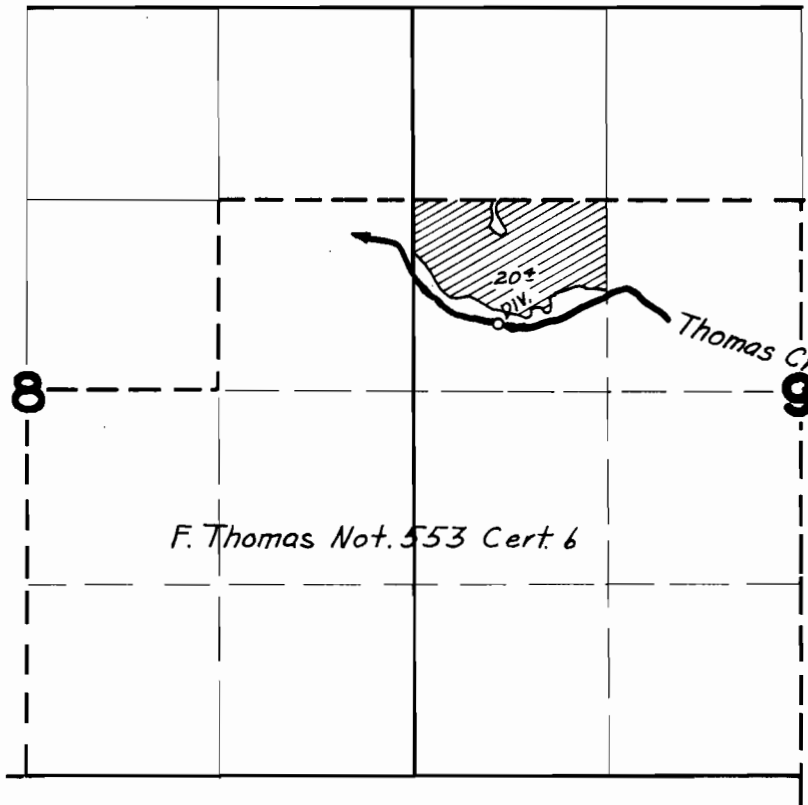

FINAL PROOF SURVEY UNDER

Application No. 25310 Permit No. 19863
IN NAME OF

Hans & Vada C. Petersen

Surveyed July 8 19 54, by H. L. Coffman

DFM-2D-180