


T. 1N. R. 12 & 13E. WM

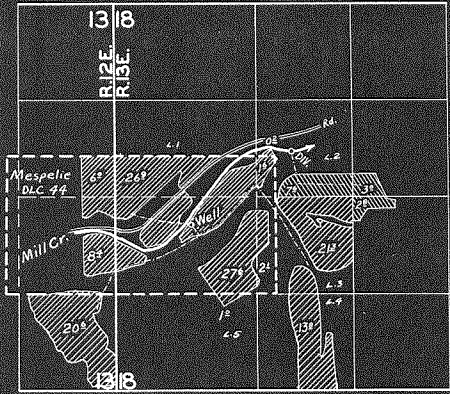

FINAL PROOF SURVEY

UNDER

Application No. 10 Permit No. 150

IN NAME OF

as shown on attached map

Surveyed June 10 19 11, by C. H. Hopper

