


T. ., R. ., W.M.

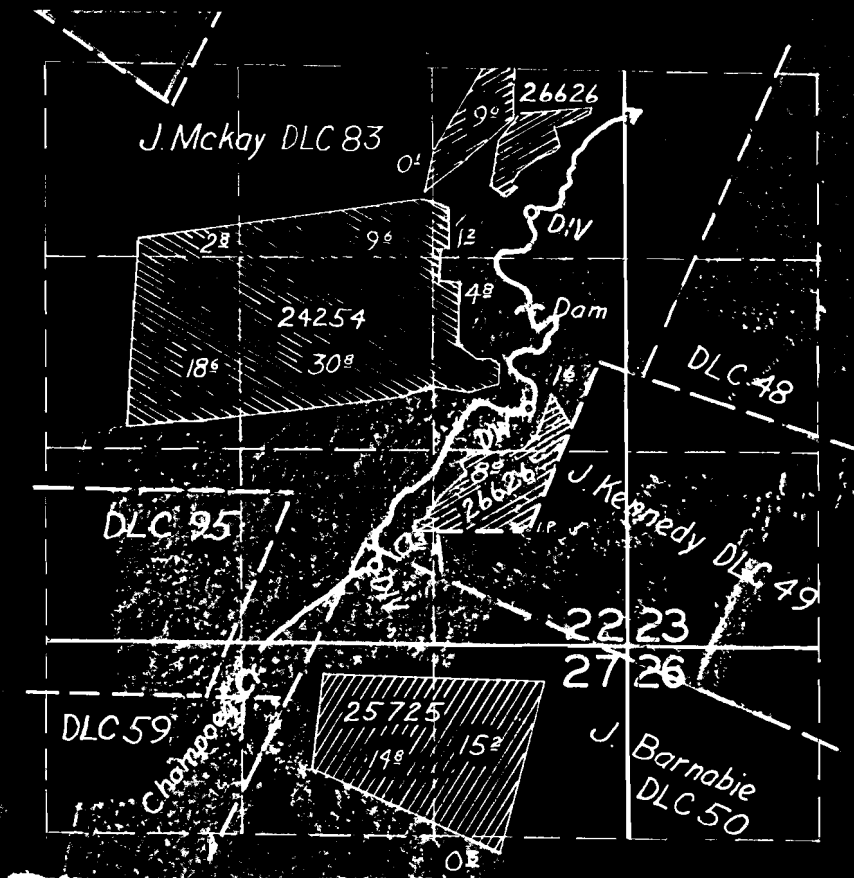

FINAL PROOF SURVEY
UNDER

Application No. Permit No.
IN NAME OF

Surveyed 19 by