


T.24S.R.5W.W.M.

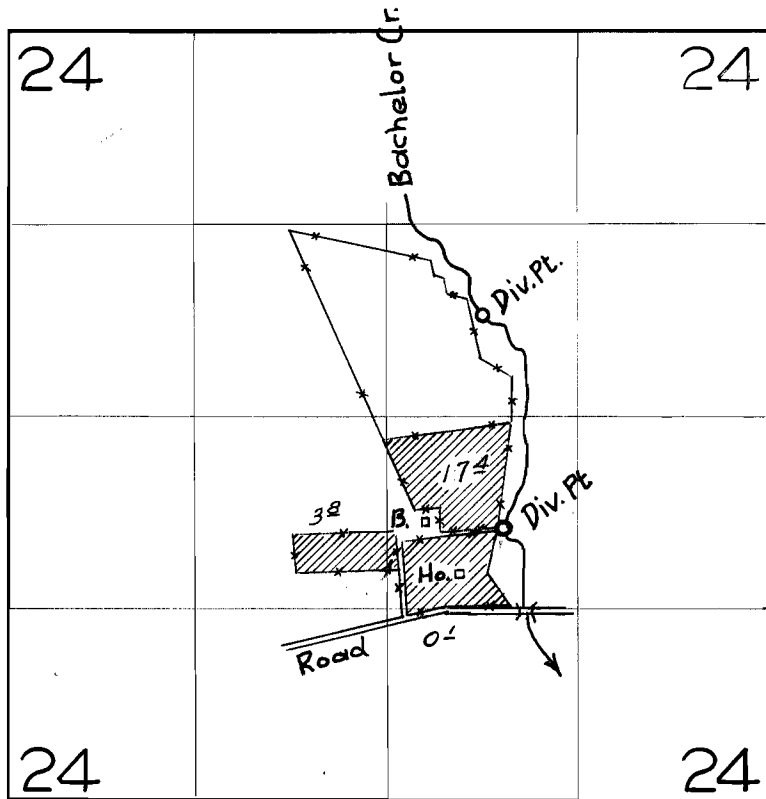

FINAL PROOF SURVEY UNDER

Application No. 25751 Permit No. 20151
IN NAME OF

L. C. Perrin

Surveyed July 26, 1954, by H. L. Coffman