


T.13S.R.1W.WM

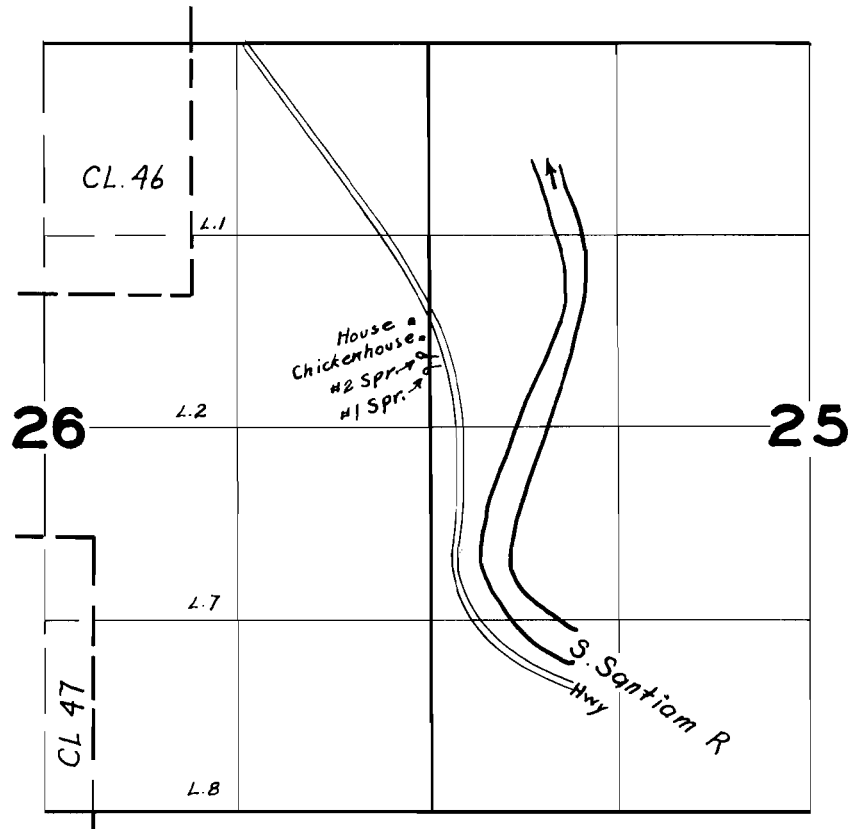

FINAL PROOF SURVEY
UNDER

Application No. 25801 Permit No. 20280
IN NAME OF

W. R. and ~~Lola~~ Horner

Surveyed Aug. 6 1954, by H. L. Coffman