


T. 8 S., R. 3 W., W.M.

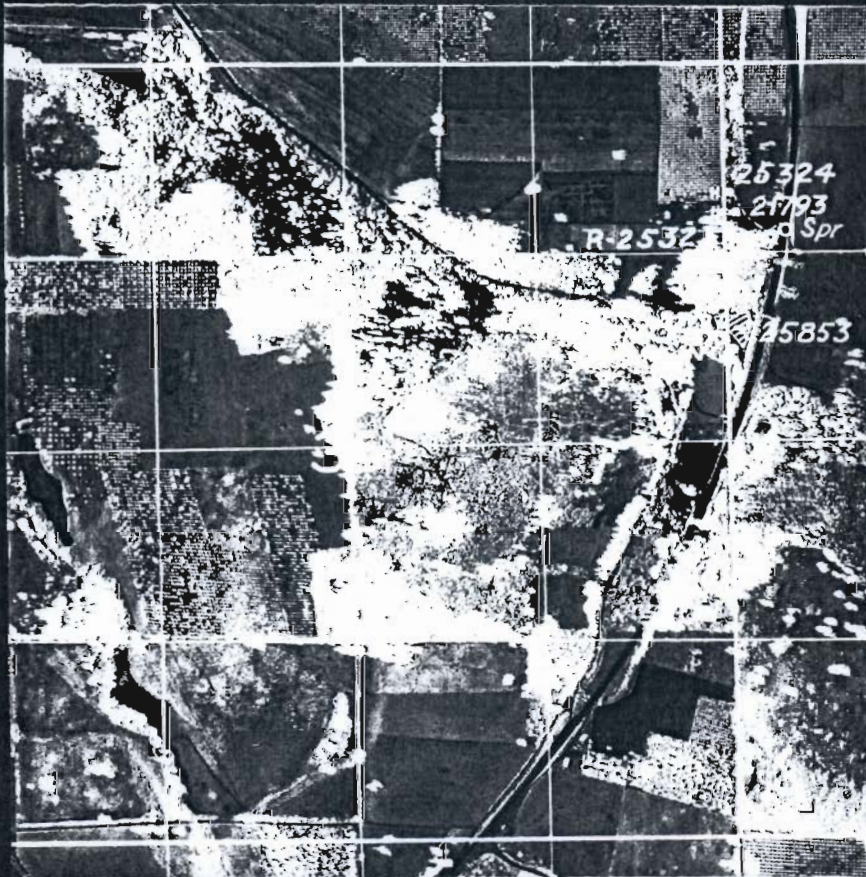

## FINAL PROOF SURVEY

Name	Appl. No.	Permit No.
Ernest Neuenschwander	21793	17146
Roy M. Smith	25853	20304
Merle Loll	25324	19978
Merle Loll	R-25323	R-1100

Surveyed April 14 1954, by T. Jones

DFN 3D 61