


T.I.S.R.I.W.W.M

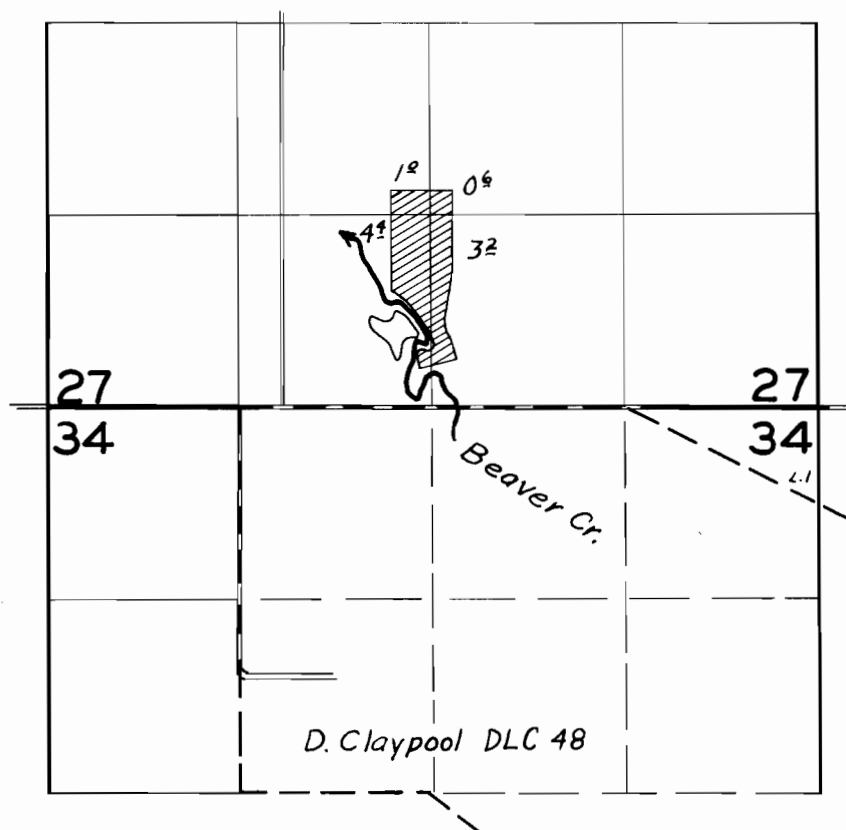

FINAL PROOF SURVEY
UNDER

Application No. 25877 Permit No. 20313
IN NAME OF

Virgil M. Reeves

Surveyed July 16, 1954, by H. L. Coffman