


# T.16S.R.4W.WM

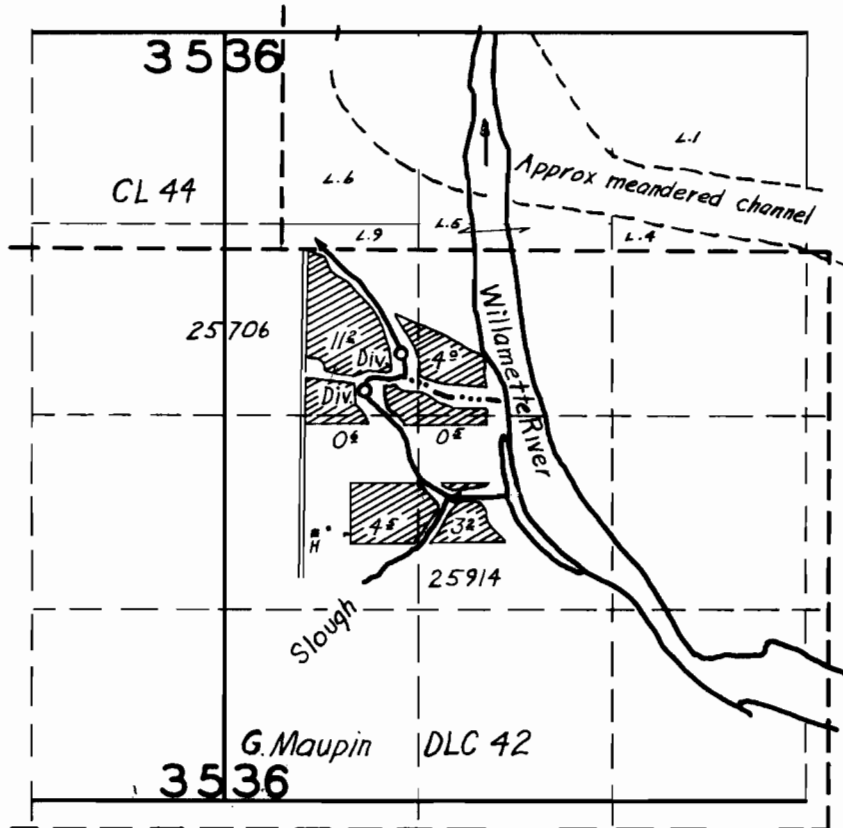

## FINAL PROOF SURVEY

UNDER

Application No. 25706 Permit No. 20387  
25914 20251

IN NAME OF

Signal Lake

Chris S. Christianson

Surveyed April 21 1954, by J. L. Callman