


FROM OFFICE OF THE STATE ENGINEER, SALEM, OREGON

July 1909

July 1909

Willow Creek Adjudication

3 S. 25 E.
Part 4 S. 25 E.

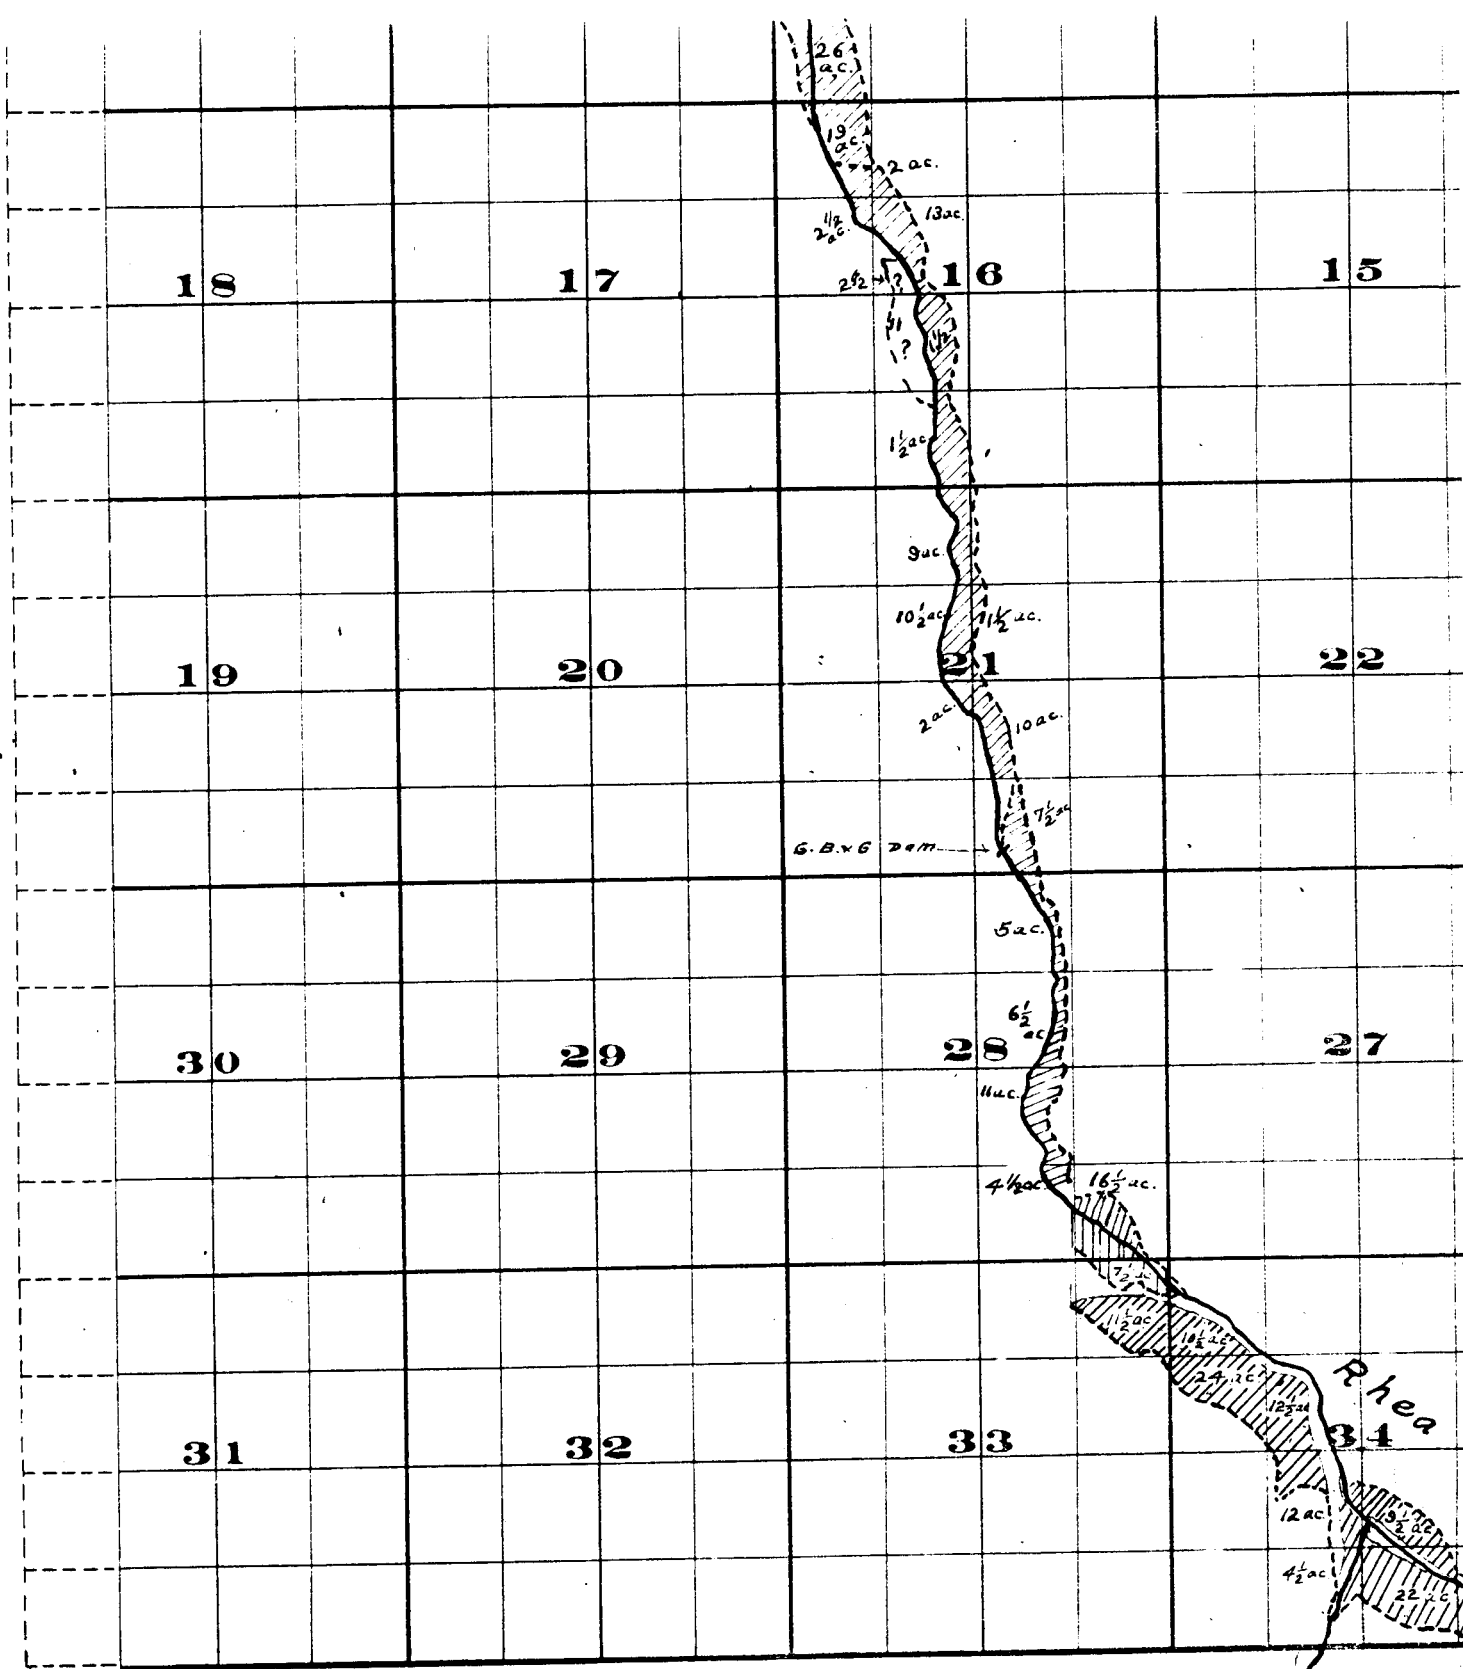


THE S. A. BRISTOL CO. PRINTERS & BOUNDERS, CHICAGO, ILL.

S. 28 - North Surveyed by R. D. Cooper July
 S. 33 - South Surveyed by H. K. Donnelly July
 John H. Lewis - State Engineer
 Examined July 14, 1909.

Township 35

, 1

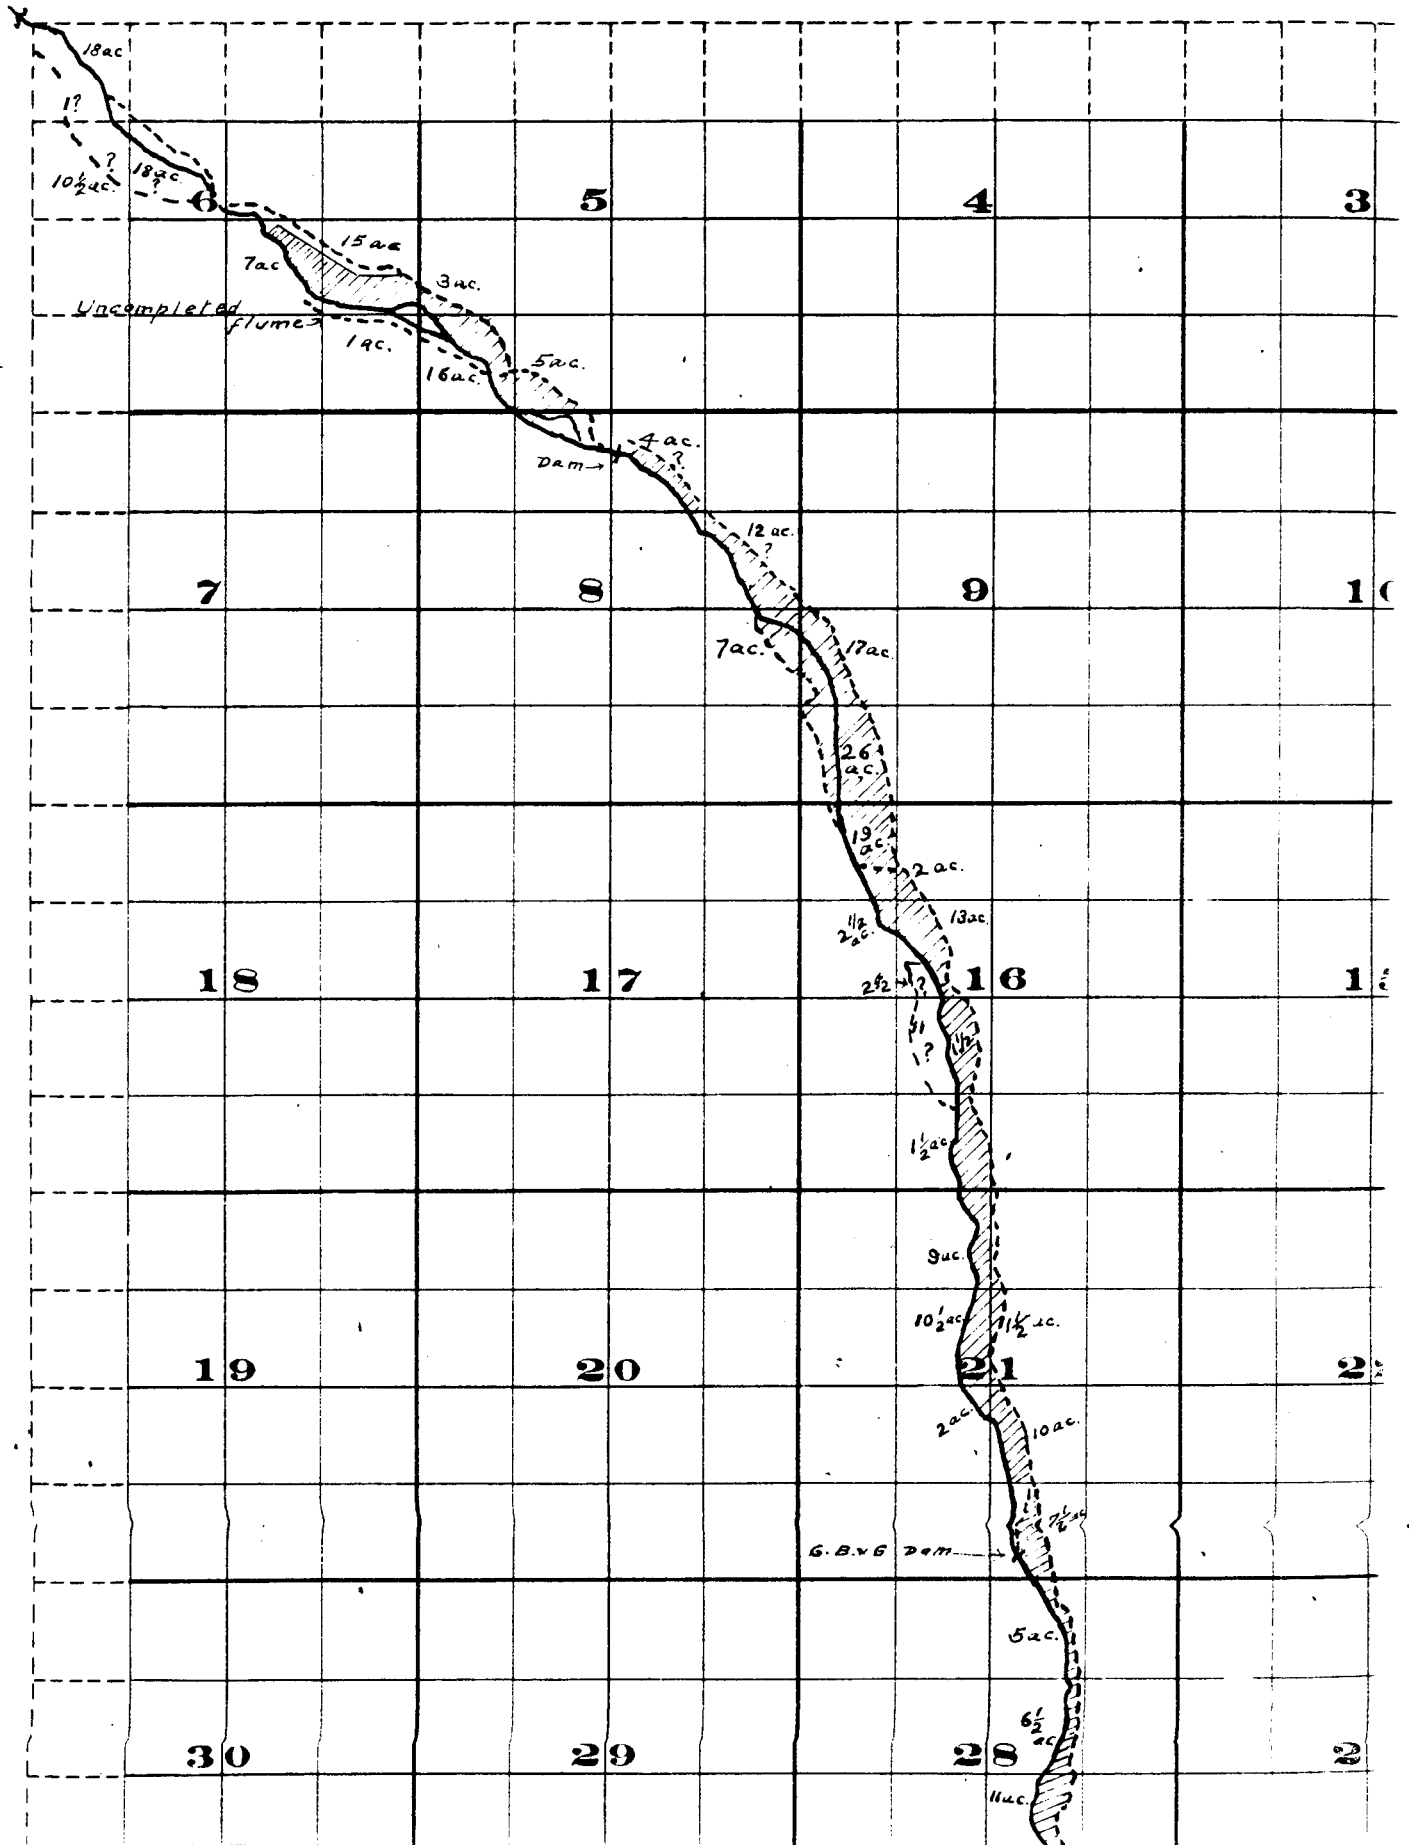

, Range 25 E.W.M. .

