


T. 18 S., R. 2 W., W.M.

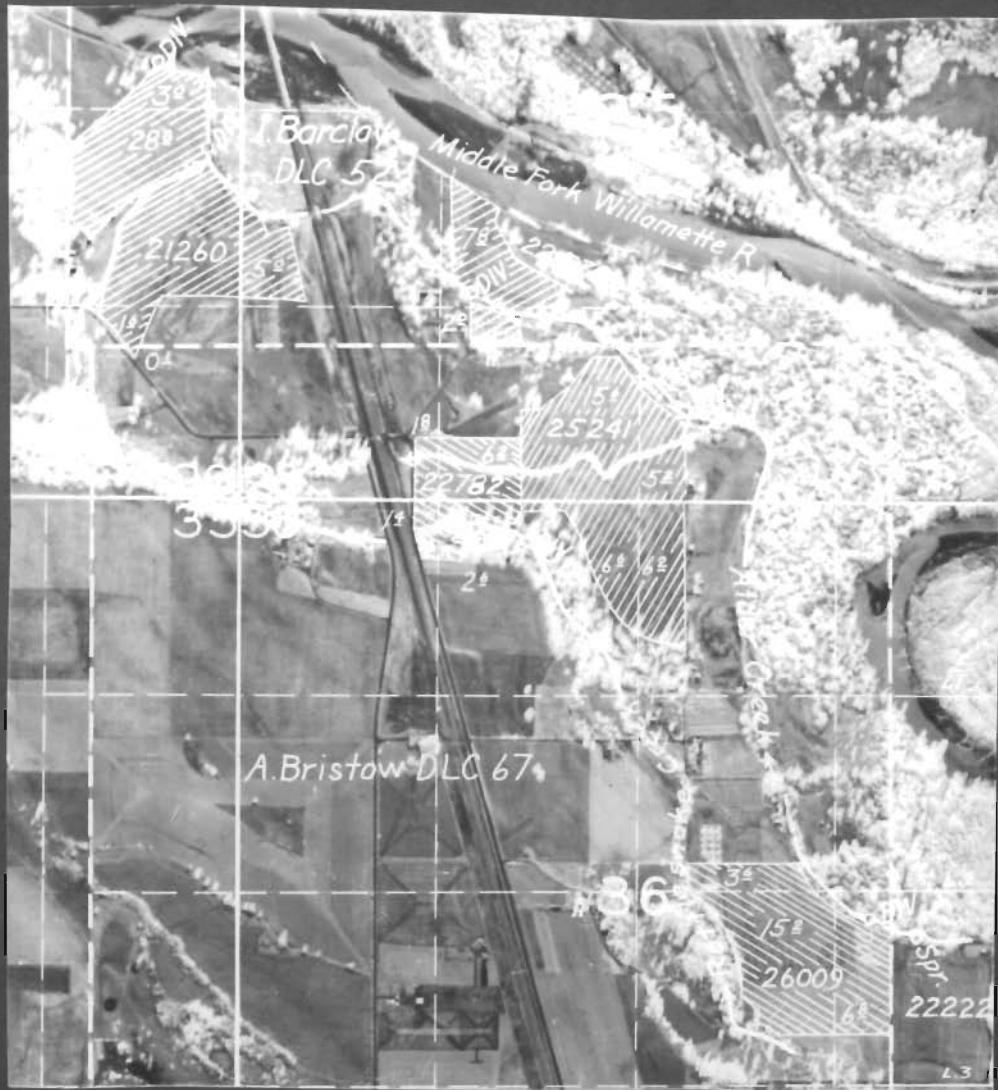

## FINAL PROOF SURVEY

J. S. Frank	Appl. No. 21260	Permit No. 16913
Gainey E. & Hattie B. Jacoby	25241	19829
Gainey E. & Hattie B. Jacoby	22782	17943
Emil A. Haniuk	26009	20374
Ray Andrews	22570	17764
Paul D. Green	22222	17496

Surveyed April 27, 1954, by T. Jones  
May 3