


T.26S.R.6W.W.M.

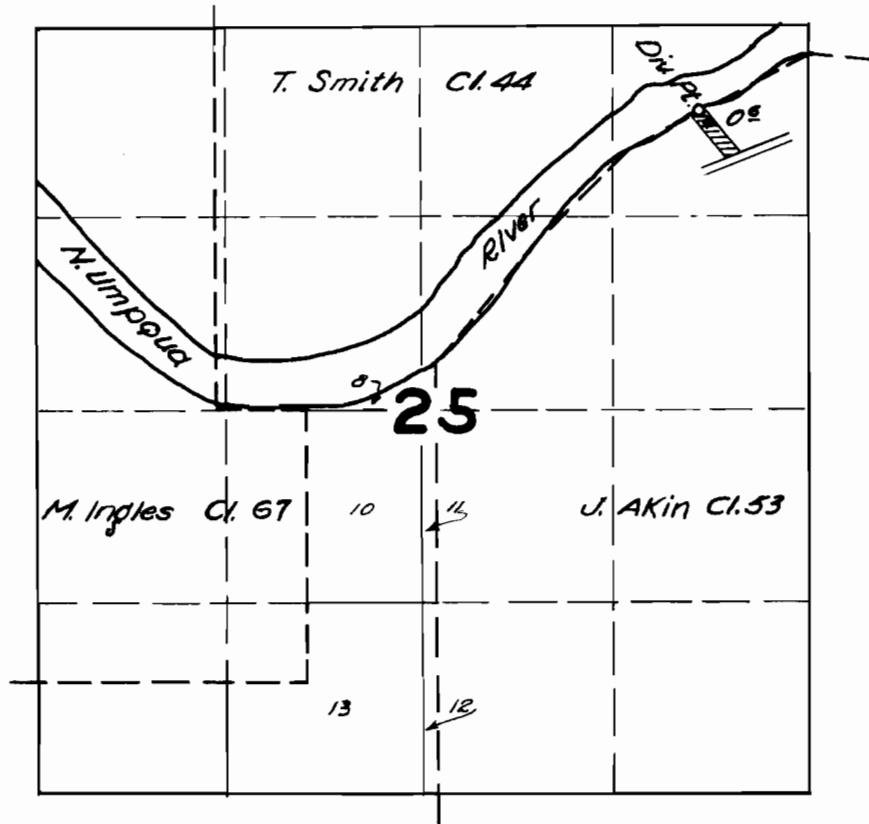

FINAL PROOF SURVEY

UNDER

Application No. ...26067... Permit No. 20392.....

IN NAME OF

.....George H. & Mazie E. Smith.....

Surveyed July 22, 1954, by H. L. Coffman.

1954-A