


T.13S. R.1 W.W.M.

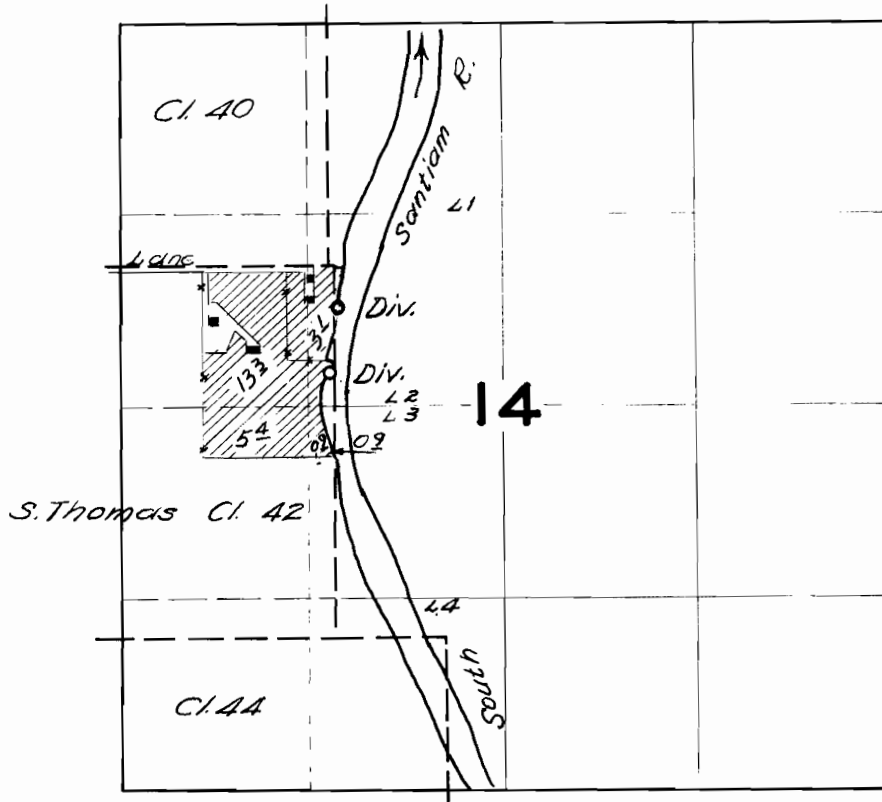

FINAL PROOF SURVEY

UNDER

Application No. 26211 ... Permit No. 20439....

IN NAME OF

Edward L. Walton

Surveyed Aug. 18, 1954, by J. L. Coffman

D. 14-135
Santograph