


# T.12S.R.1W.WM

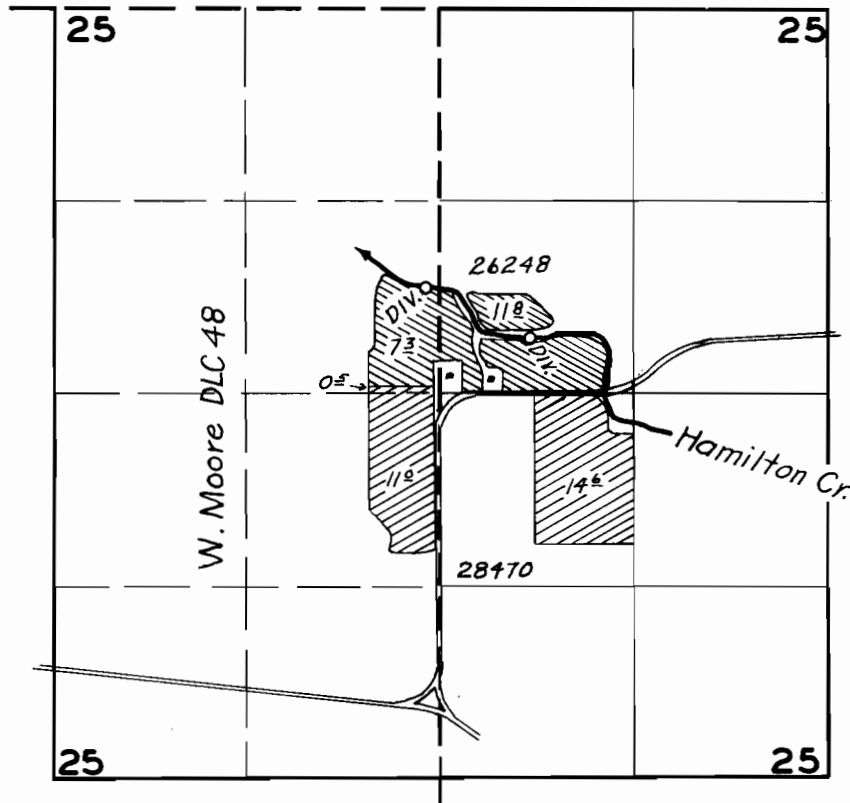

## FINAL PROOF SURVEY

UNDER

26248

20453

Application No. 28470... Permit No. 22297...

IN NAME OF

Granford G. Burrell & Bernice L. Burrell

Surveyed Aug. 5, 1954, by H. L. Coffman