


T.17S. R. 3W. WM

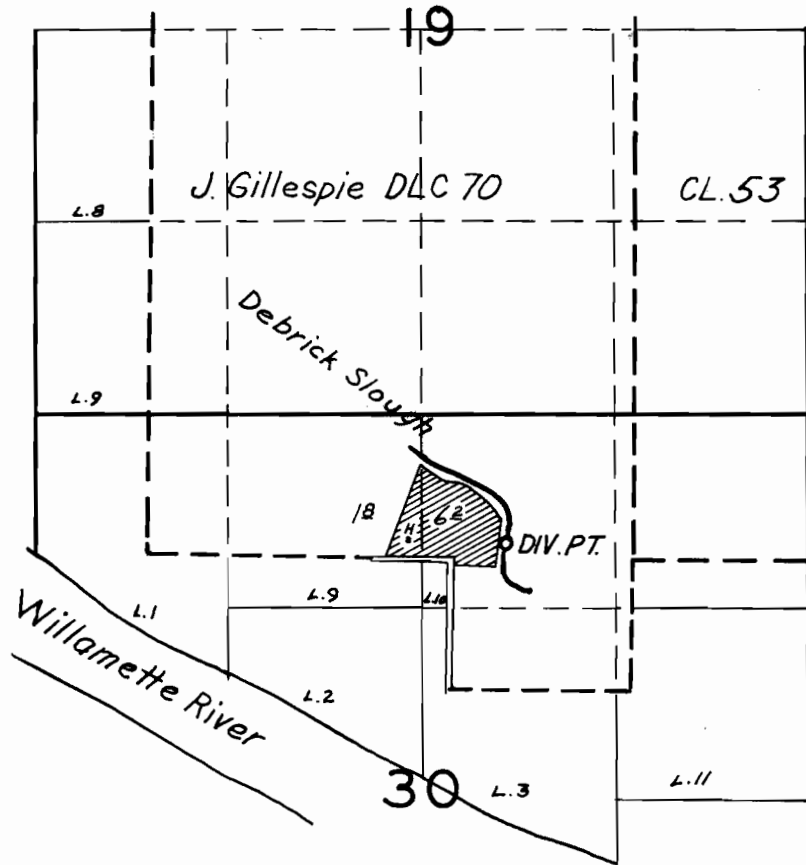

FINAL PROOF SURVEY

UNDER

Application No. 26225 Permit No. 20411

IN NAME OF

Rolan L. Lucile

Surveyed April 22 1954, by T. Jones