


T.7 S.R.5W.WM

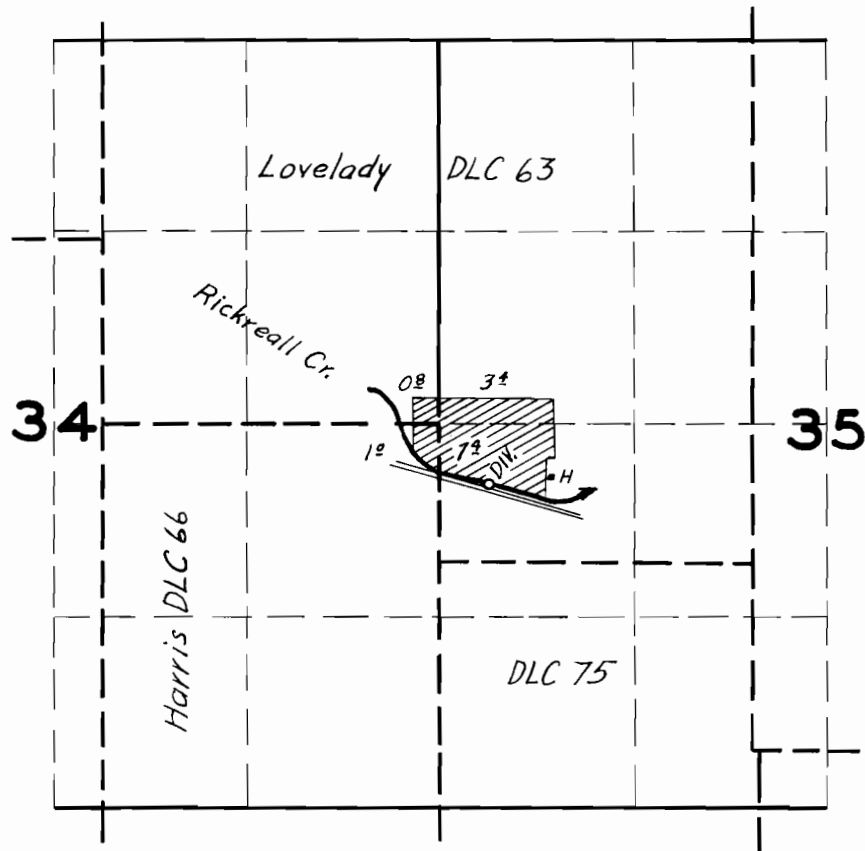

FINAL PROOF SURVEY

UNDER

Application No. 26295 ... Permit No. 20640 ...
IN NAME OF

Bruce Cooley

Surveyed Aug. 5, 1954, by T. Jones