


T. 18 S., R. 23 E., W.M.

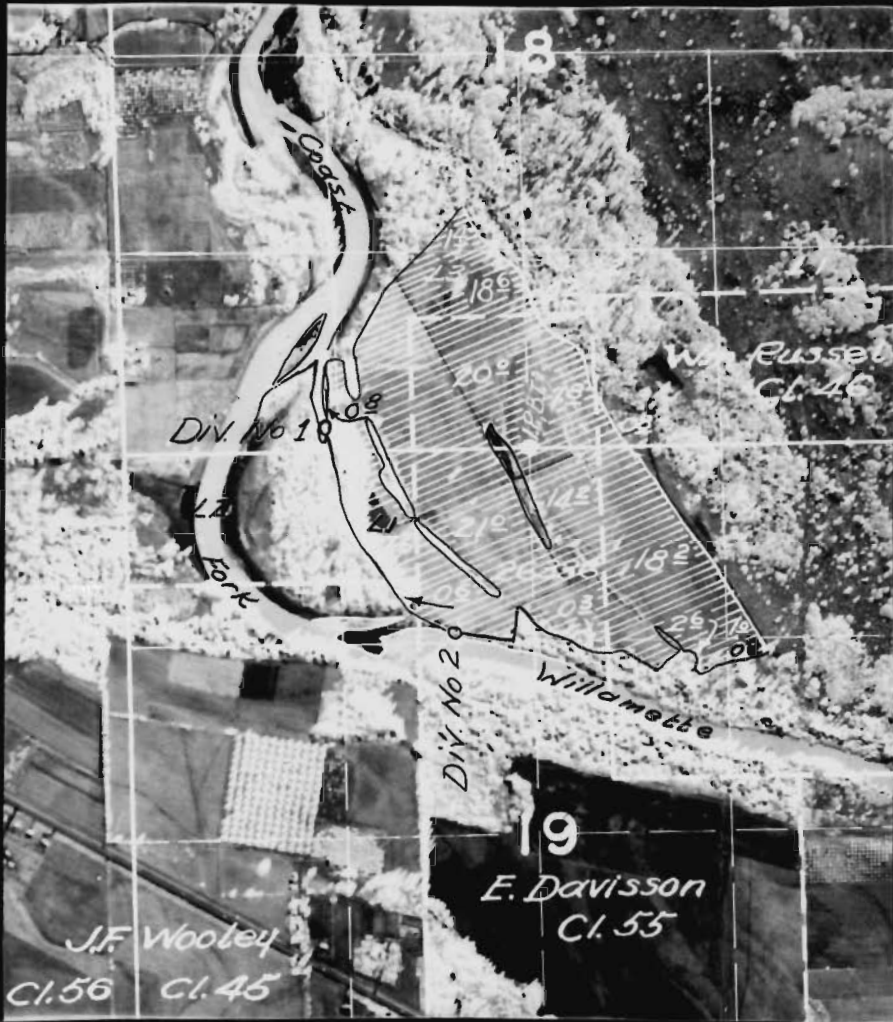

**FINAL PROOF SURVEY**  
UNDER

Application No. 26336 Permit No. 20661  
IN NAME OF

Ronald Mac Isaac

Surveyed May 5 1954, by H. L. Coffman