


T. 28 S. R. 6W. W. M.

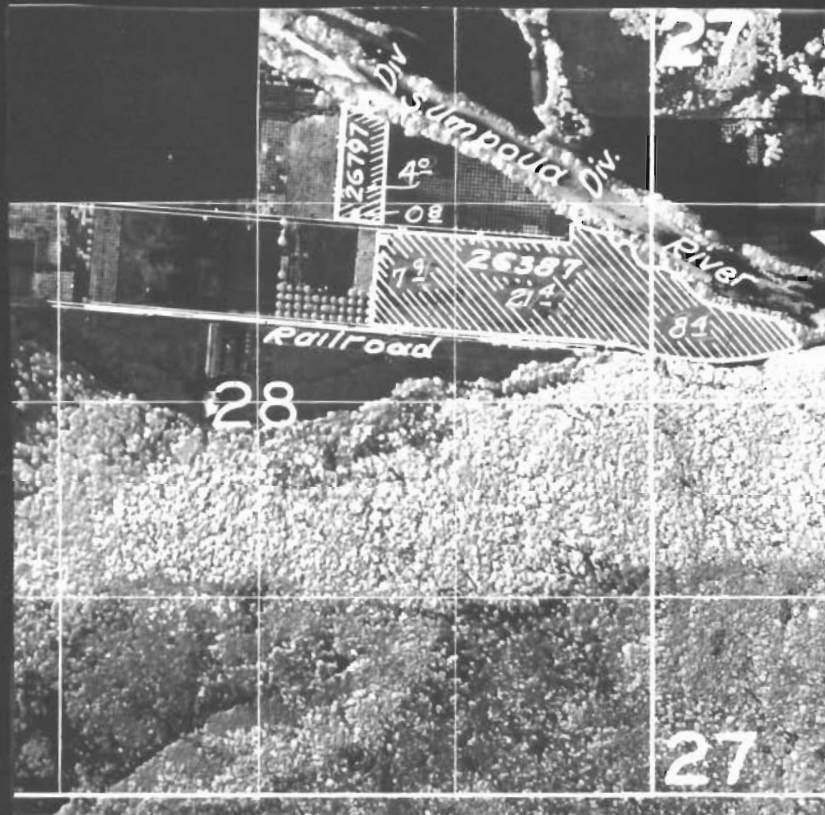

FINAL PROOF SURVEY

UNDER

Application No. 26797 Permit No. 21051
Application No. 26387 Permit No. 20702

IN NAME OF

Floyd L. Baughman
Roy C. Burks

Surveyed July 22, 1954 by H. L. Coffman

Db-Hw-18-69